



GOOGLE STREETVIEW - APPEARS TO BE AN IRRIGATION VALVE.

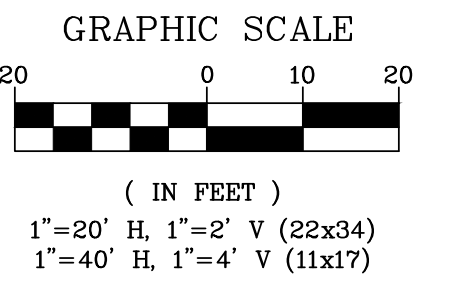

Not sure where this comm line goes. Check as-builts from franchise utilities.



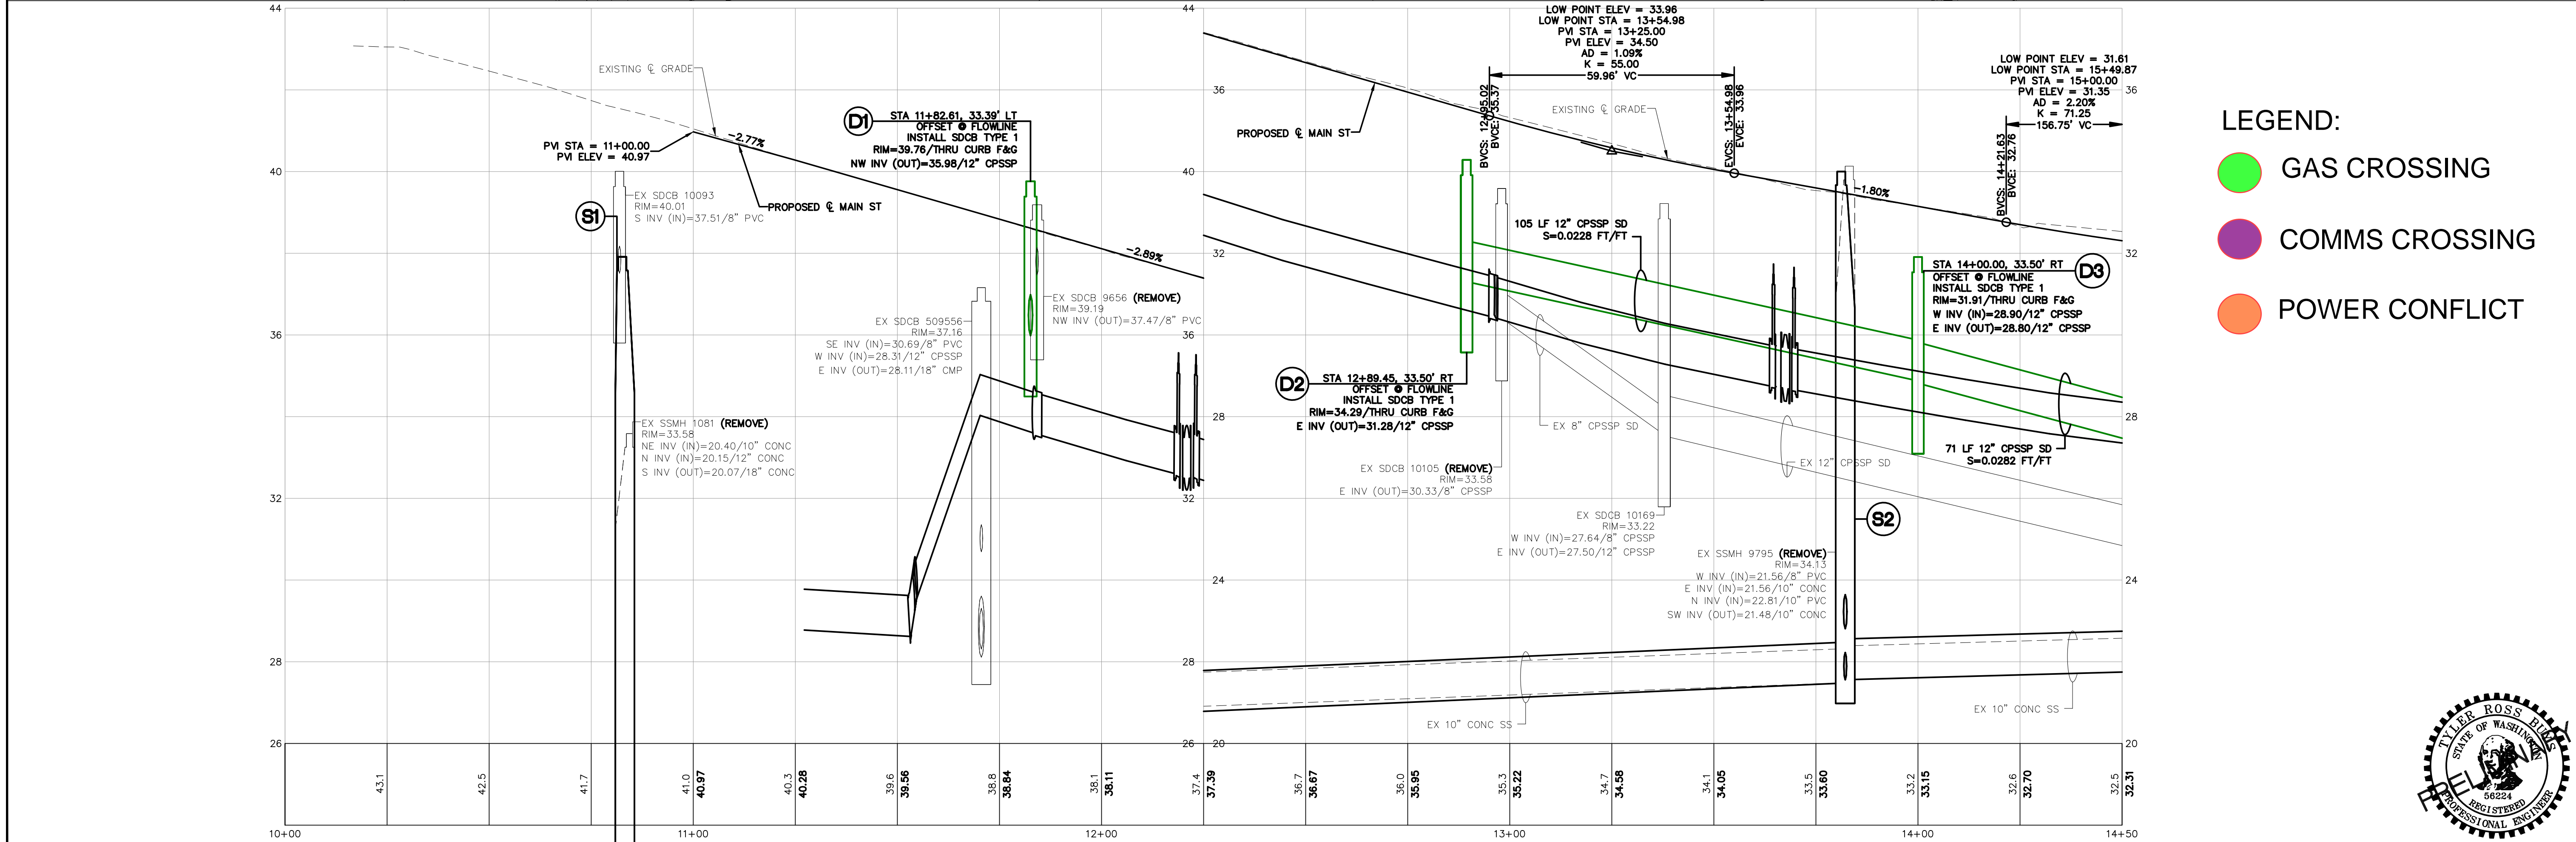


- LEGEND:**
- GAS CROSSING
 - COMMS CROSSING
 - POWER CONFLICT

| | | | | | | | | | | |
|-------------------|--------------------|--|------------|--------------------------------|-------------------|----|--|---|-----------------|-----------------|
| 60% PLANS | DESIGNED BY TRB | R&E Reichhardt & Ebe ENGINEERING INC P.O. Box 978 423 Front Street Lynden, WA 98264 (360) 354-3687 | NO. | DATE | DESCRIPTION | BY | CITY OF FERDALE 2095 MAIN ST FERDALE, WA 98248 | MAIN STREET IMPROVEMENTS BARRETT ROAD TO OLD SETTLERS DRIVE ROADWAY AND STORM PLAN - STA 10+00 TO 14+50 | DWG# 22015 PLOT | DATE 3/29/24 |
| | DRAWN BY RCS | | JOB# 22015 | SCALE H: 1"=20' V: 1"=2' | SHEET 10 of 64 | | | | | |
| CHECKED BY TRB | | | | | | | | | | |



P:\Projects\2015\150301\150301_PLOT.dwg 10 ROADWAY AND STORM PLAN - STA 10+00 TO 14+50 3/29/24 3:05:48 PM _AutoCAD PDF (General Documentation).pc3

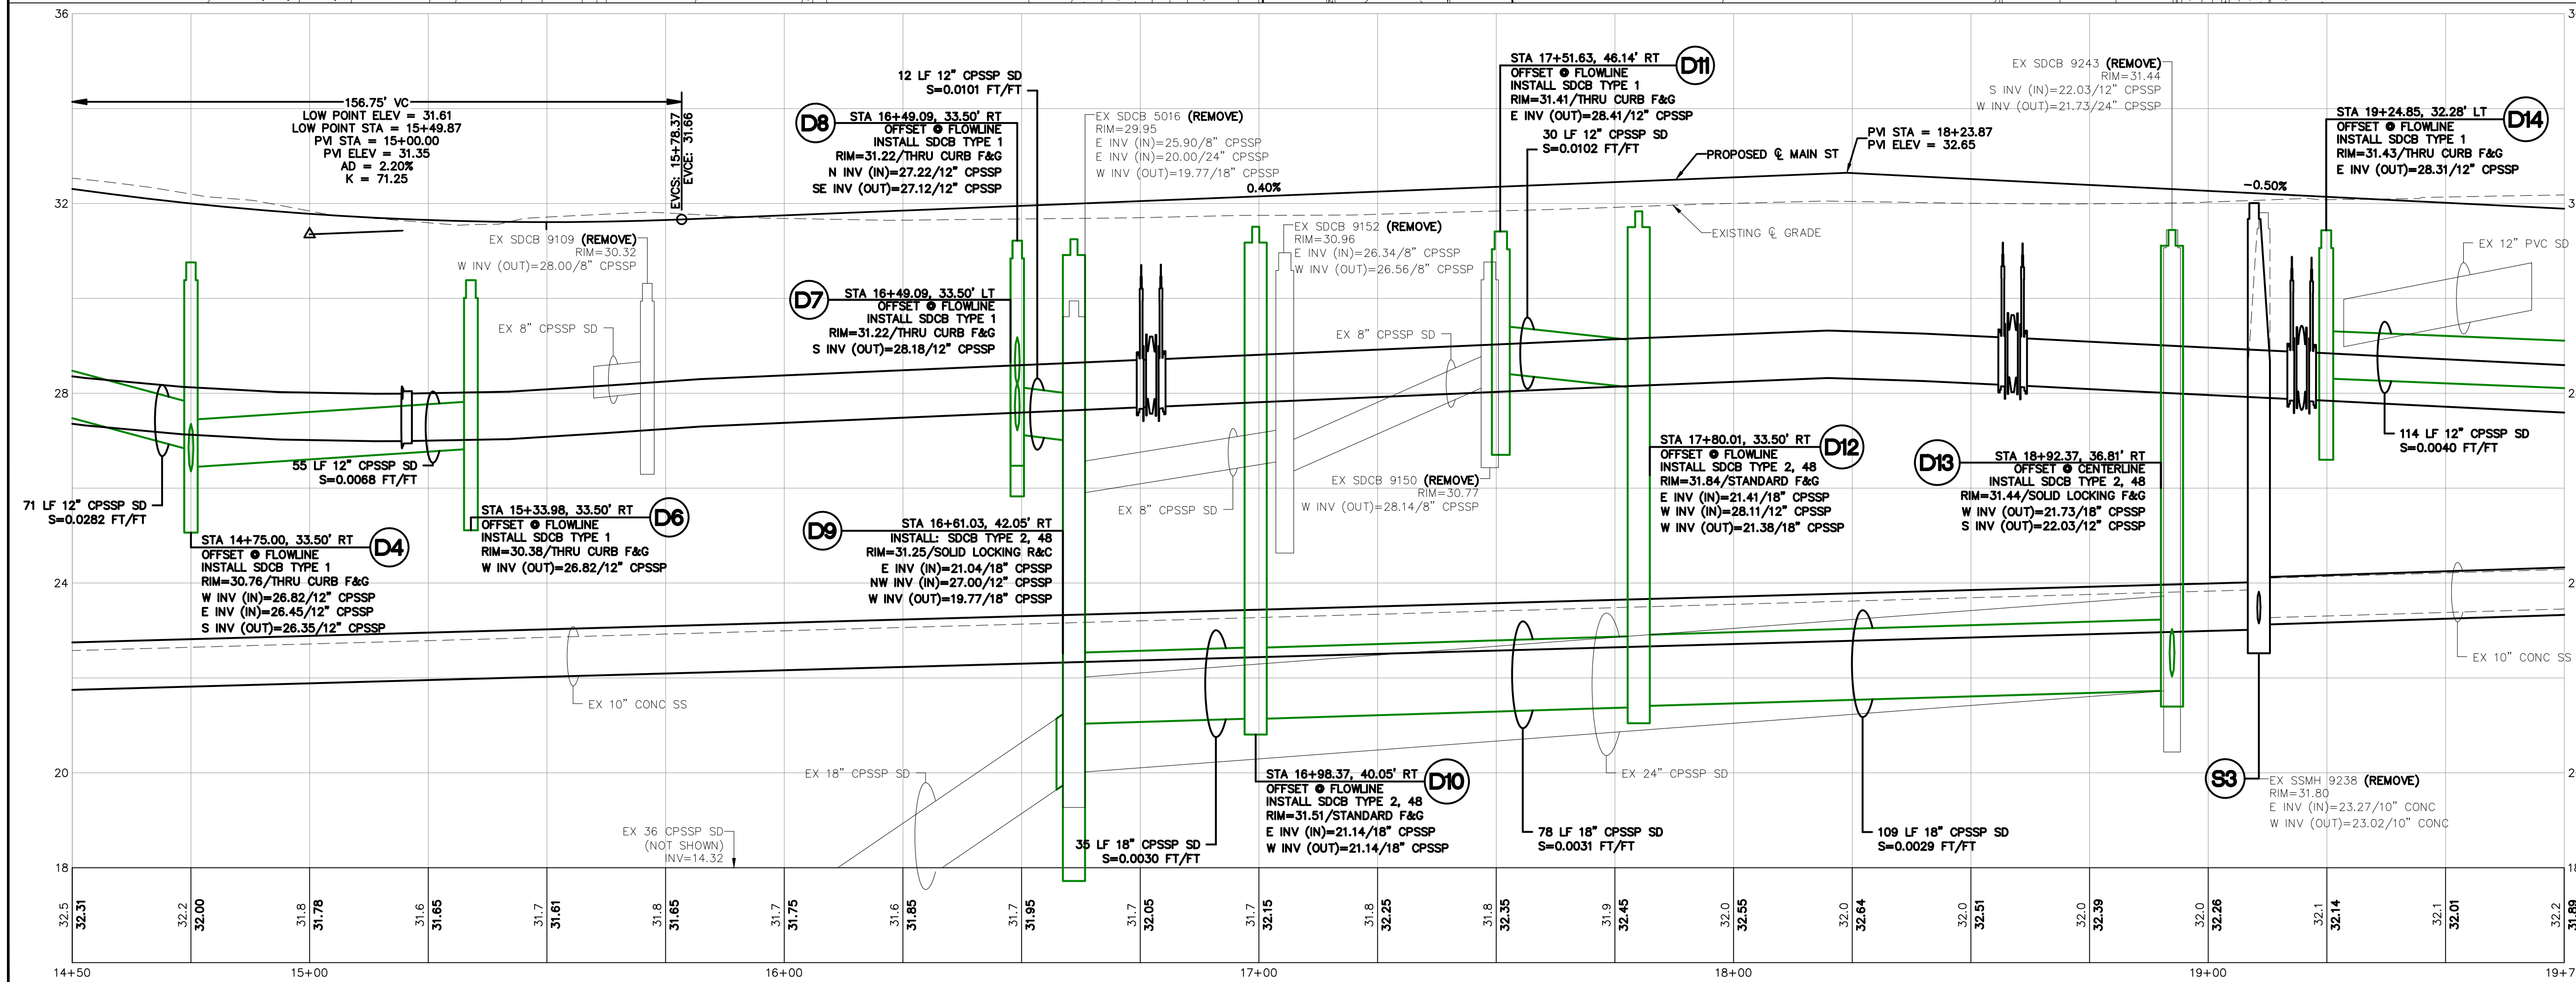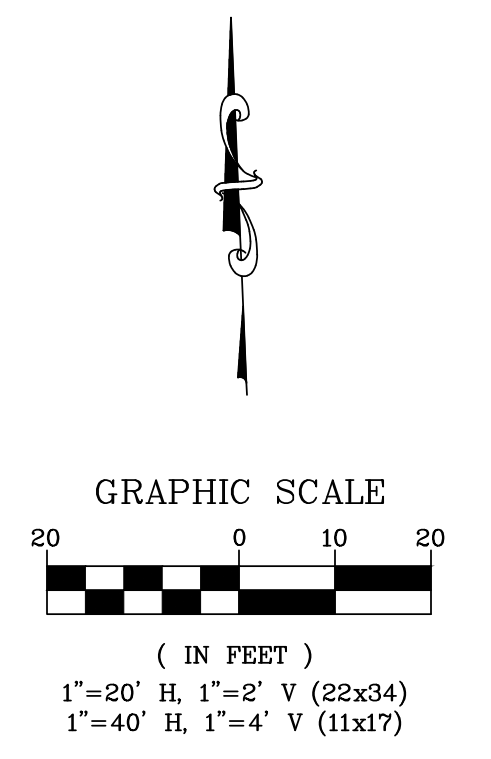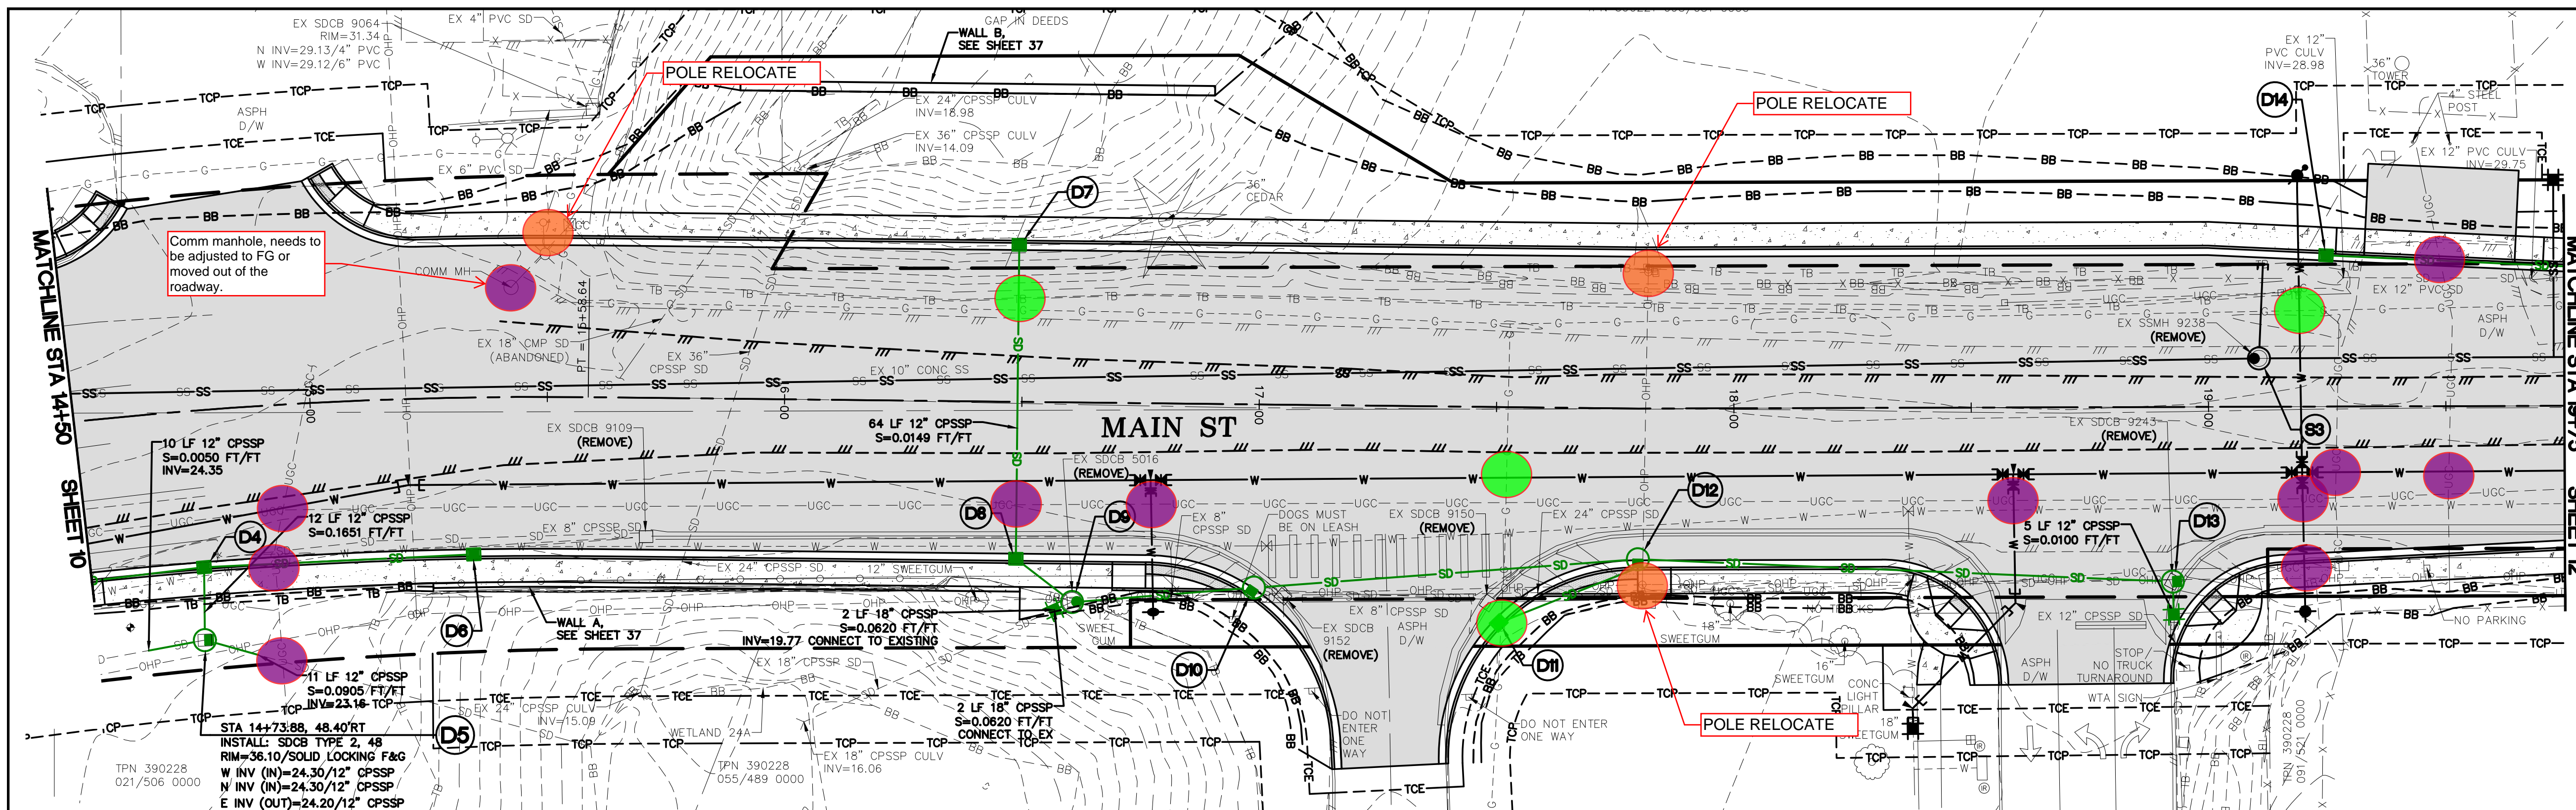

60% PLANS

DESIGNED BY
TRB

DRAWN BY
RCS

CHECKED BY
TRB


R&E Reichhardt & Ebe
ENGINEERING INC
P.O. Box 978 | 423 Front Street
Lynden, WA 98264 (360) 354-3687

| NO. | DATE | DESCRIPTION | BY |
|-----|------|-------------|----|
| | | | |

CITY OF FERDALE
2095 MAIN ST
FERDALE, WA 98248

MAIN STREET IMPROVEMENTS
BARRETT ROAD TO OLD SETTLERS DRIVE
ROADWAY AND STORM PLAN - STA 14+50 TO 19+75




DWG 22015 PLOT
JOB# 22015
SCALE H: 1"=20' V: 1"=2'

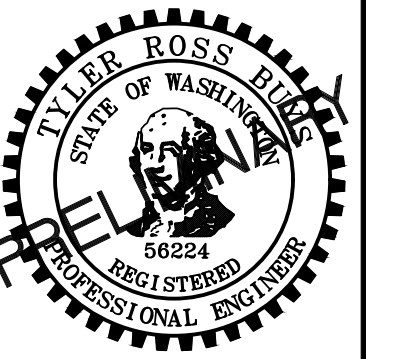

DATE
3/29/24

SHEET
11
of 64

P:\Projects\2015\03\20150315\11\ROADWAY AND STORM PLAN - STA 14+50 TO 19+75_30262024_308291.dwg - AutoCAD PDF (General Documentation).pc3

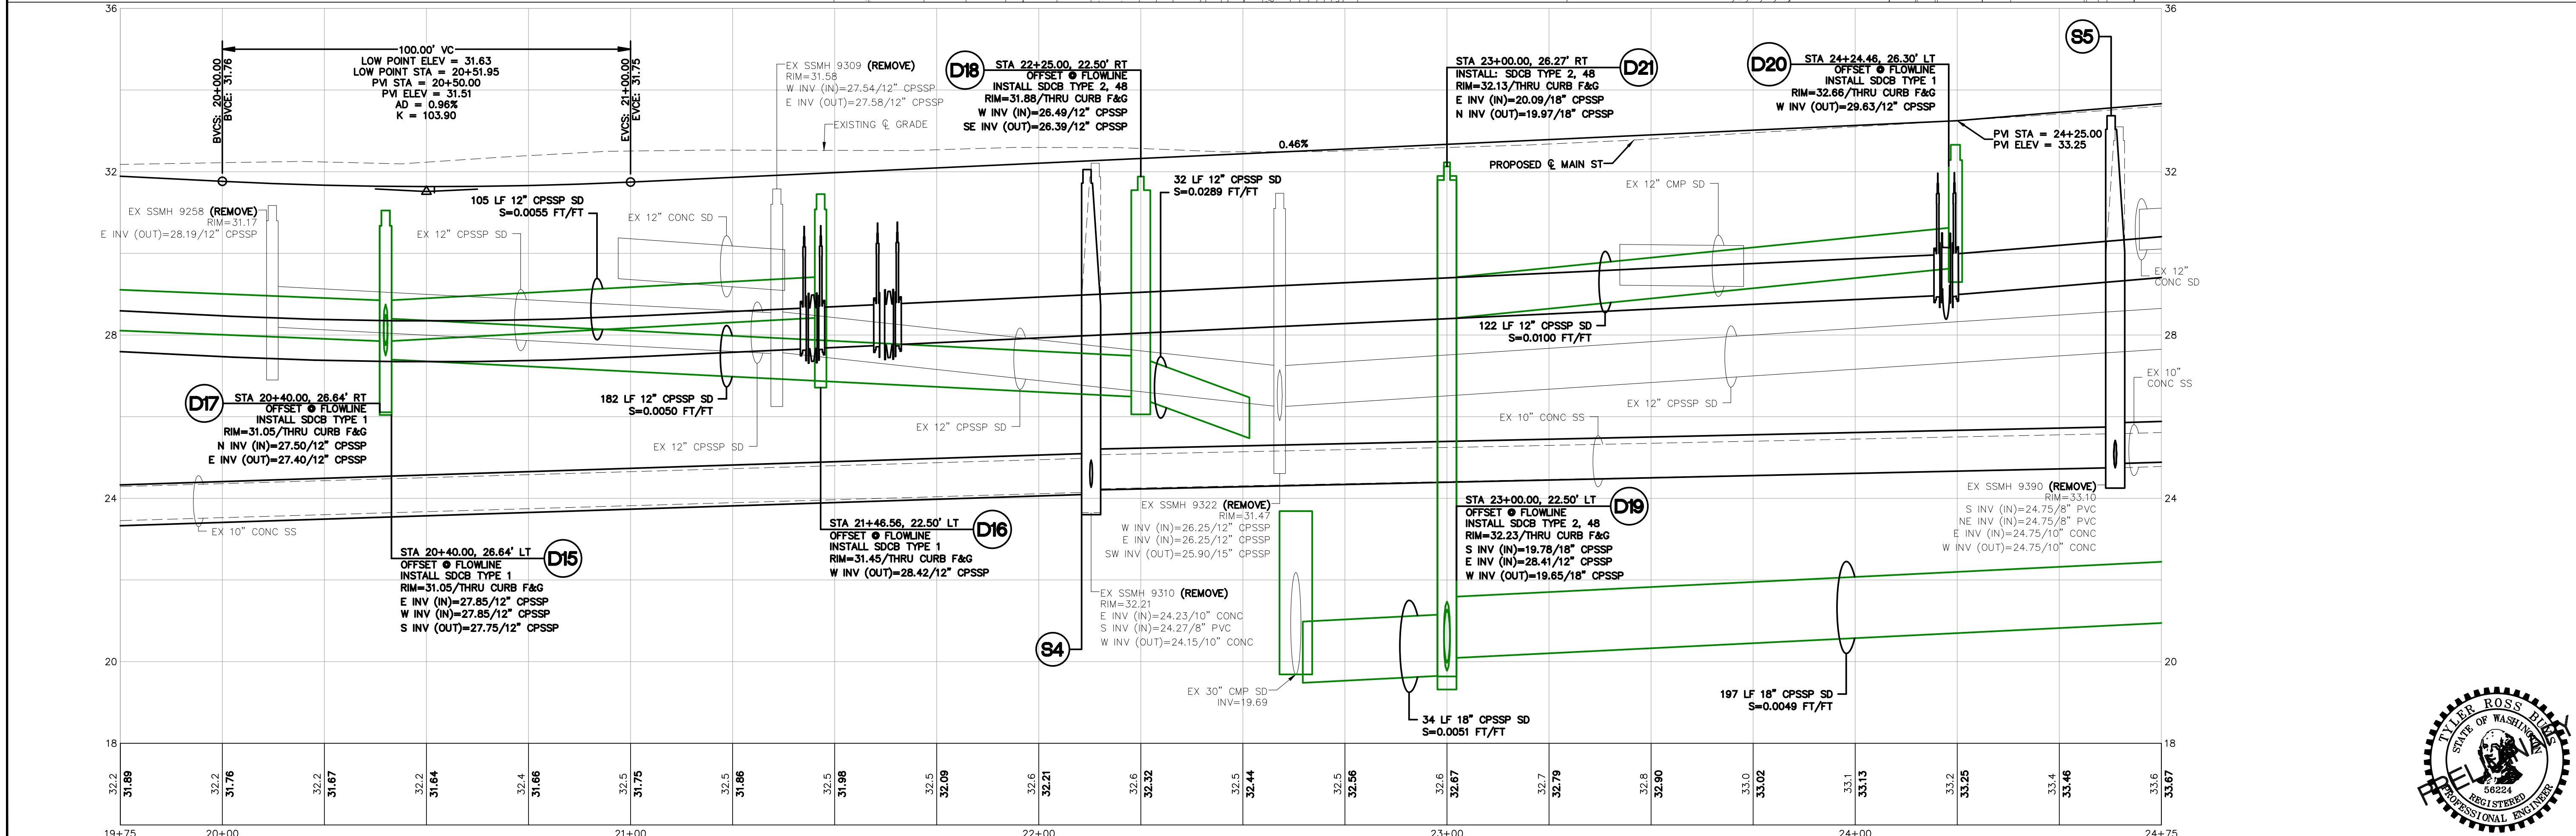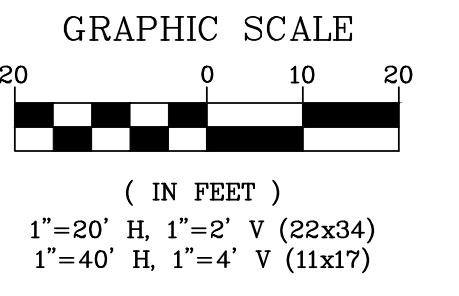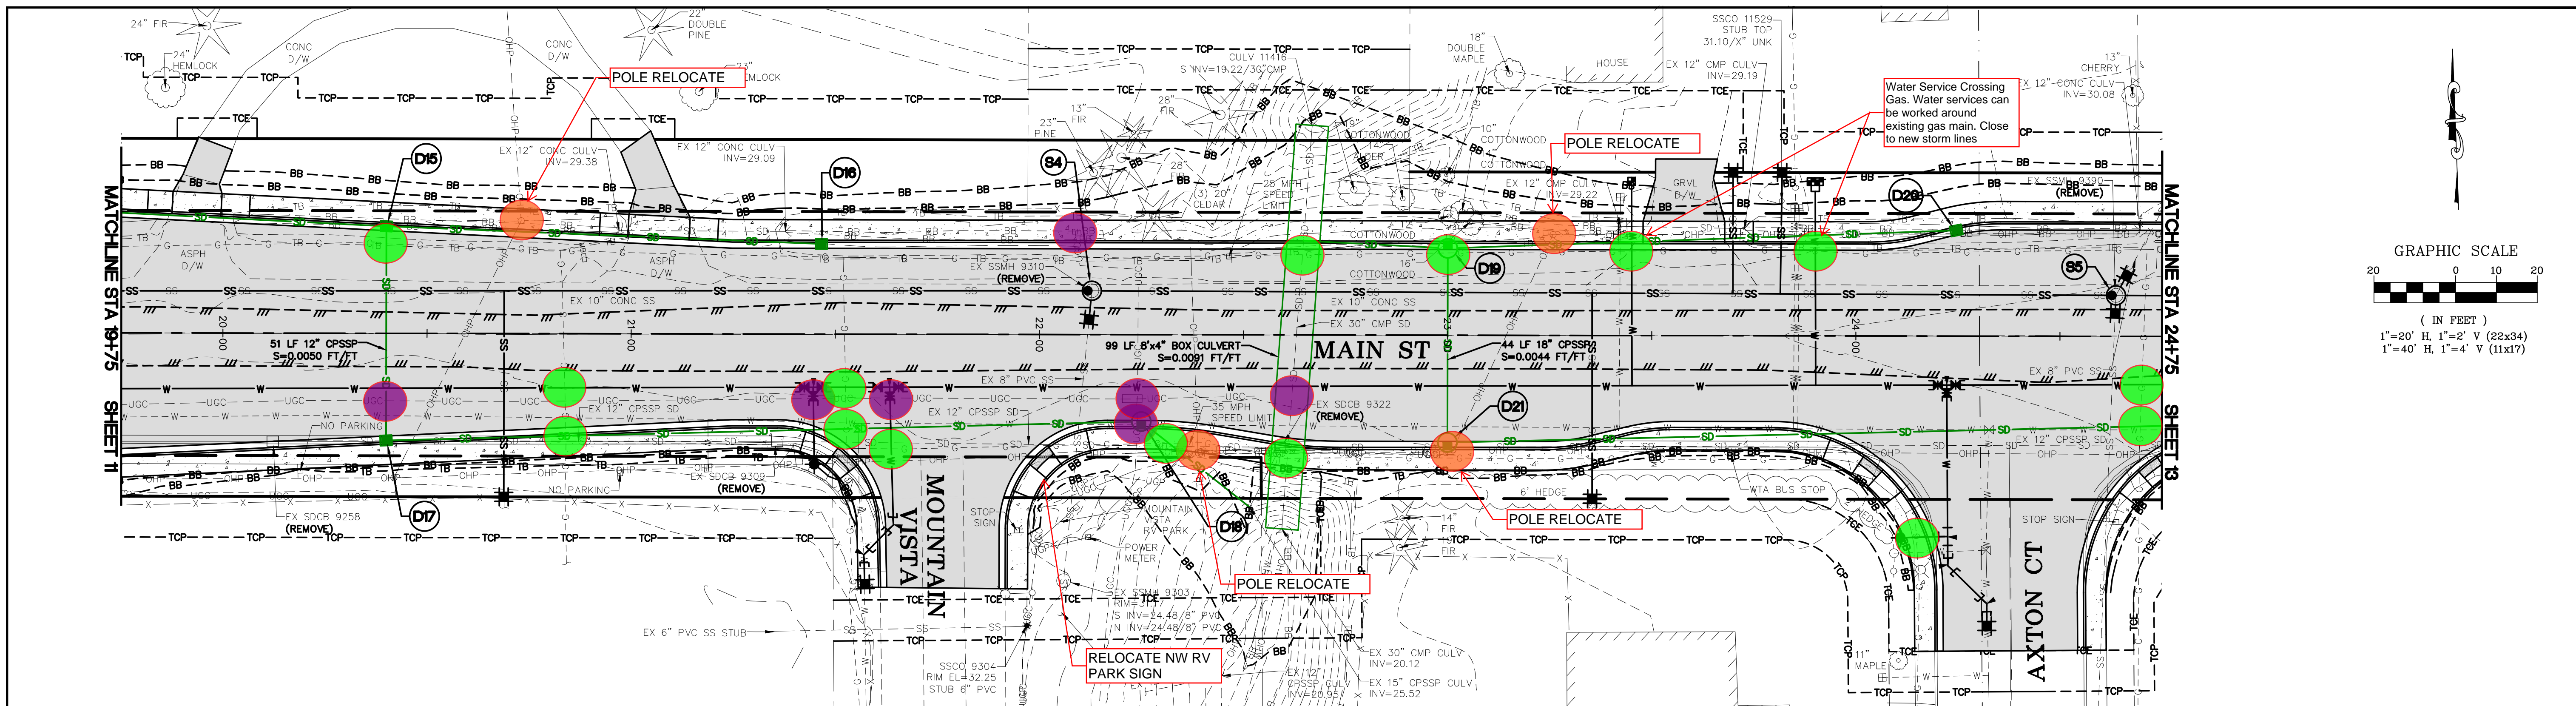

60% PLANS

DESIGNED BY TRB
 DRAWN BY RCS
 CHECKED BY TRB


R&E Reichhardt & Ebe
 ENGINEERING INC
 P.O. Box 978 | 423 Front Street
 Lynden, WA 98264 (360) 354-3687

| NO. | DATE | DESCRIPTION | BY |
|-----|------|-------------|----|
| | | | |




CITY OF FERDALE
 2095 MAIN ST
 FERDALE, WA 98248

MAIN STREET IMPROVEMENTS
 BARRETT ROAD TO OLD SETTLERS DRIVE
 ROADWAY AND STORM PLAN - STA 19+75 TO 24+75

| | |
|-----------------|--------------------------|
| DWG# 22015 PLOT | DATE 3/29/24 |
| JOB# 22015 | SCALE H: 1"=20' V: 1"=2' |
| SHEET 12 | of 64 |

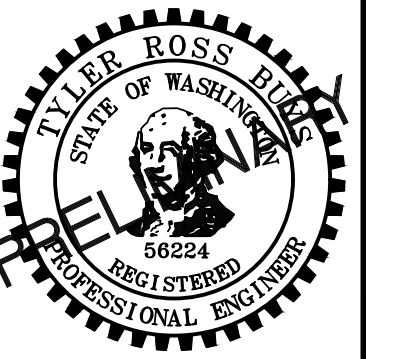

P:\Projects\2015\30 2015\2015 PLOT.dwg, IS ROADWAY AND STORM PLAN - STA 19+75 TO 24+75, 3/29/2024 3:07:15 PM, _AutoCAD PDF (General Documentation).ps3

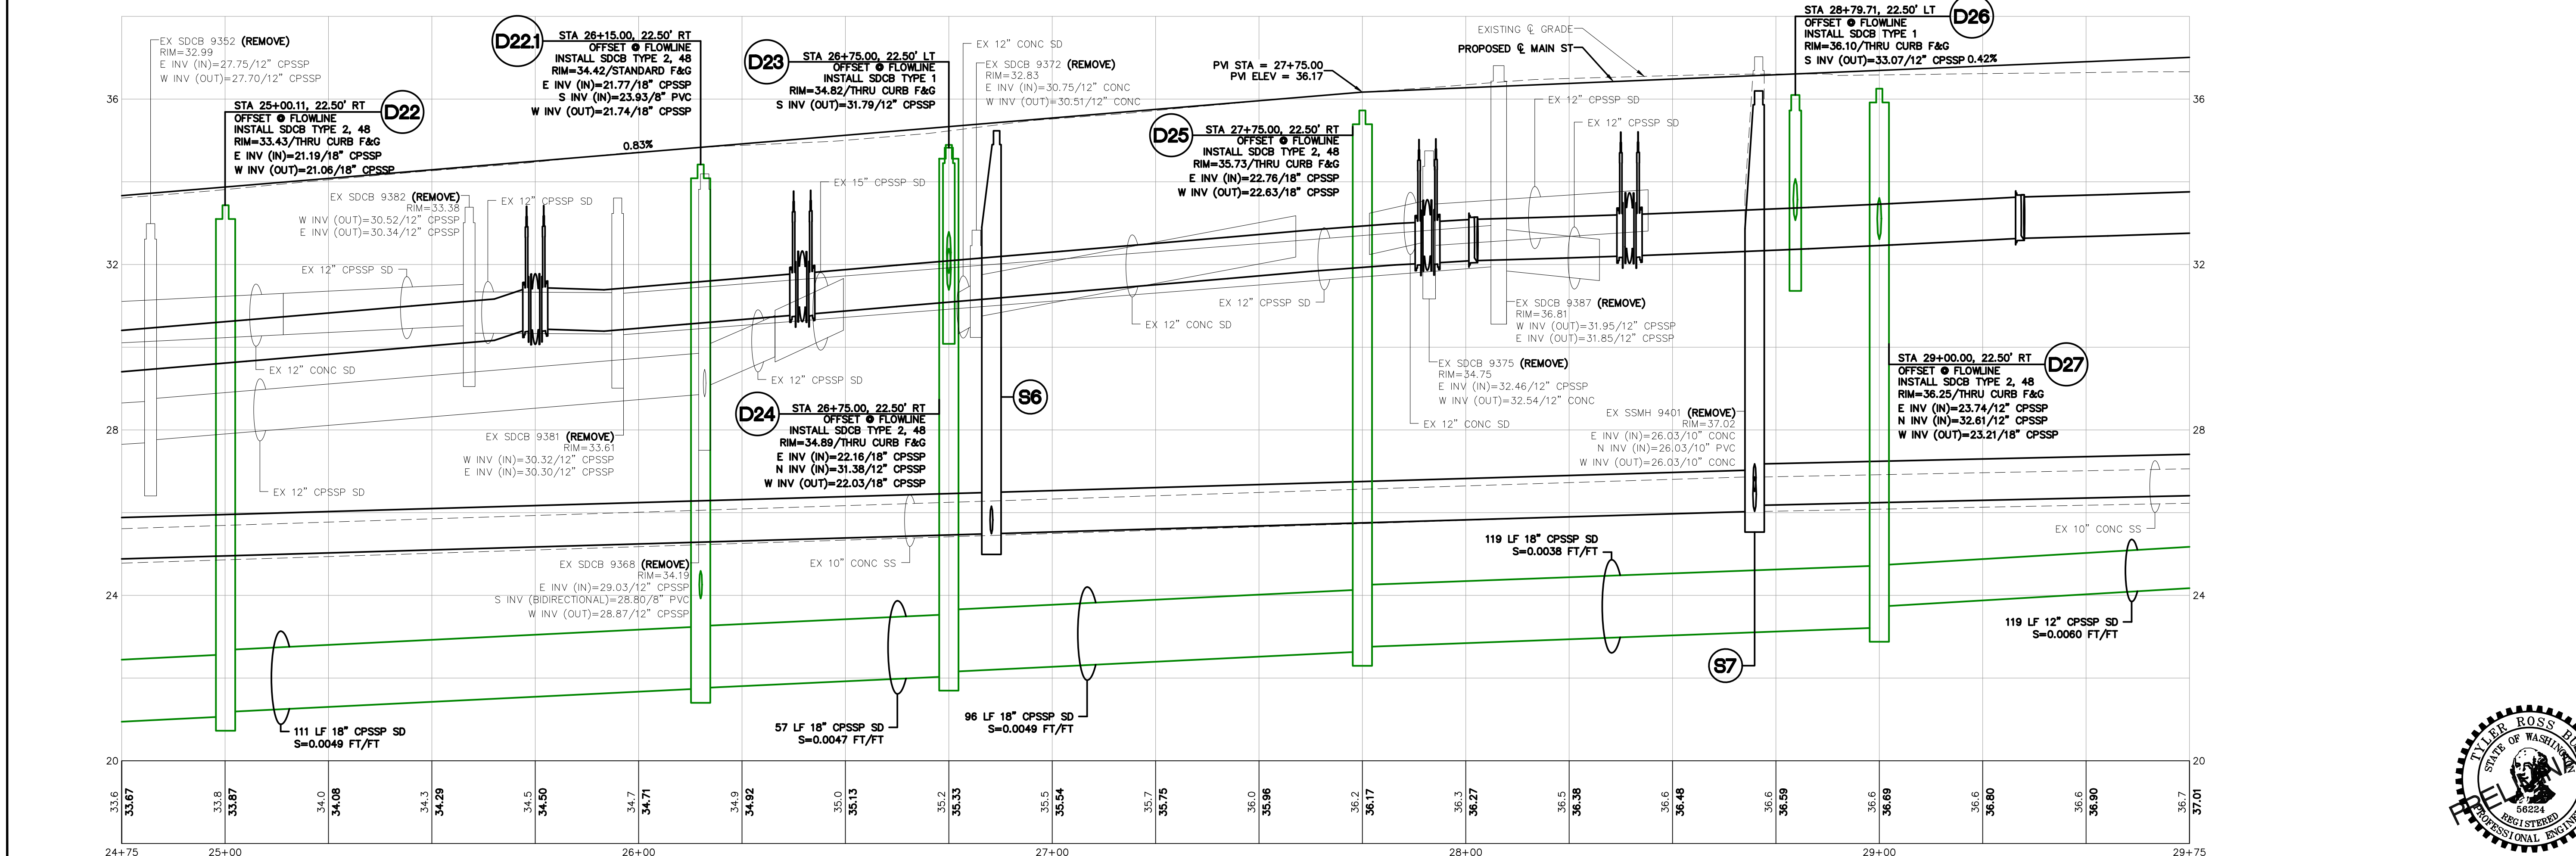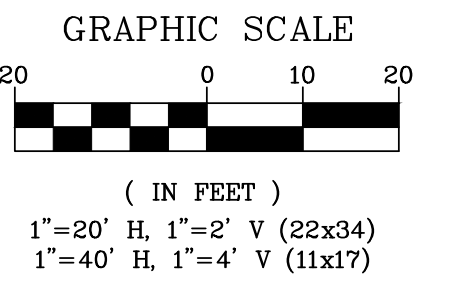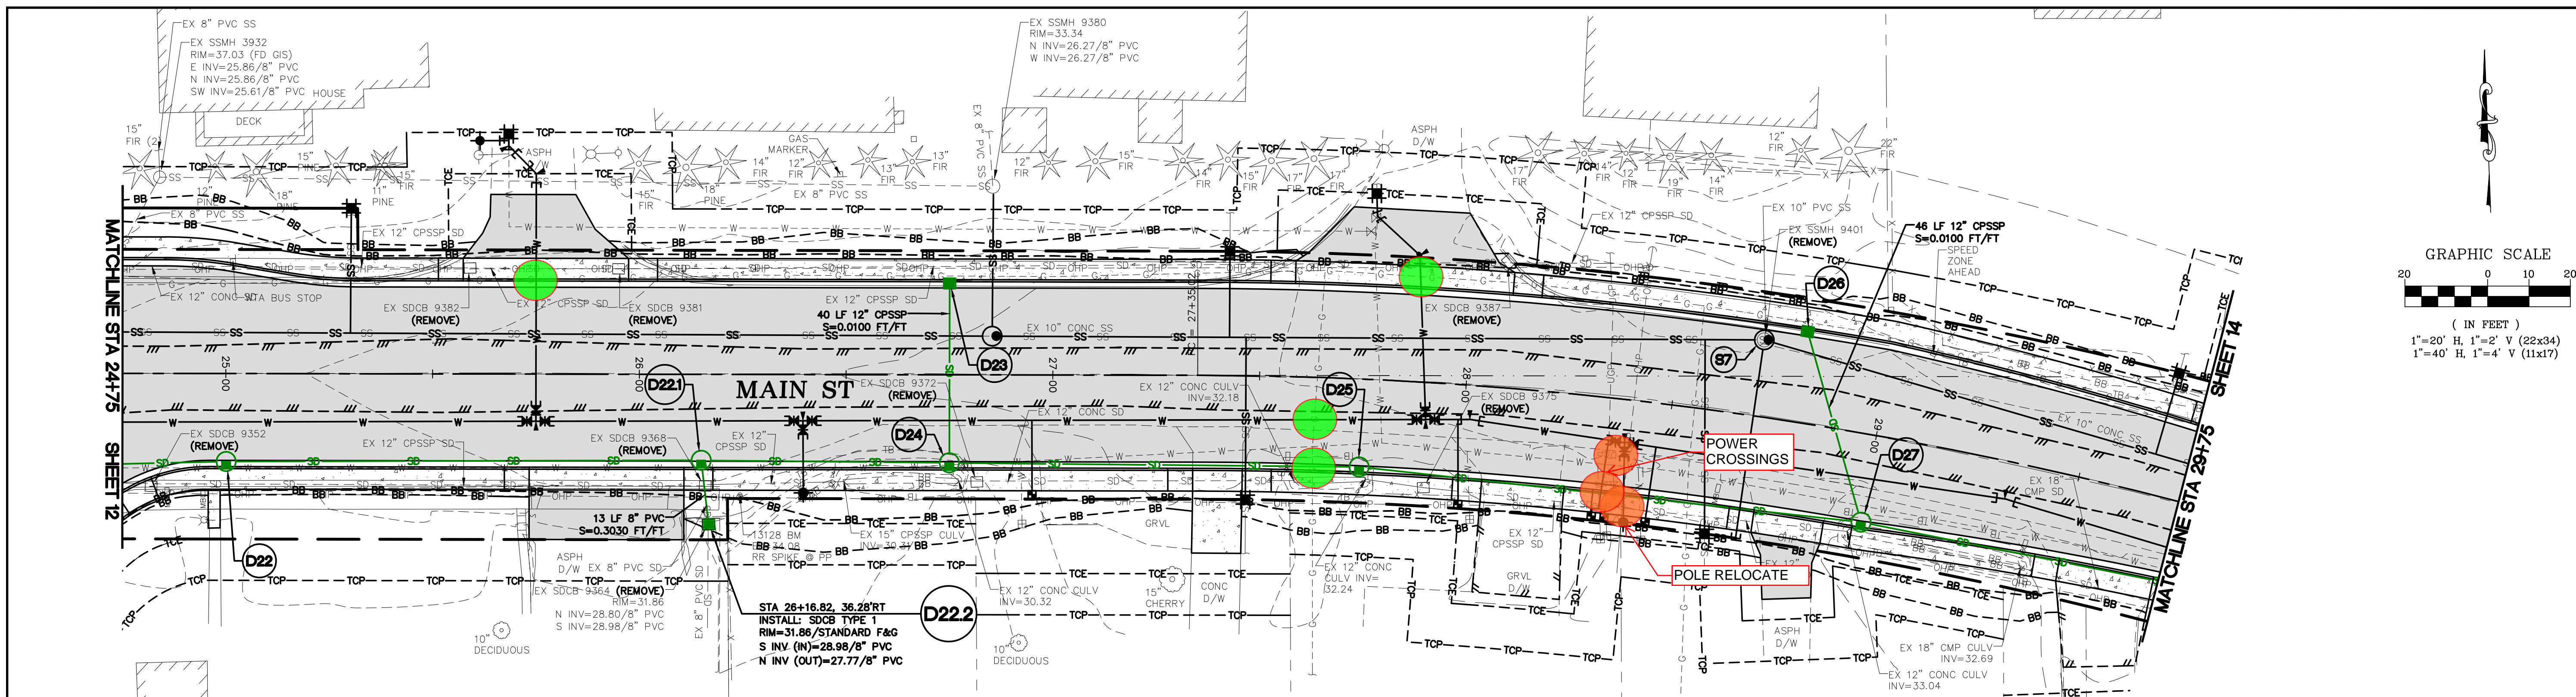

60% PLANS

DESIGNED BY
TRB

DRAWN BY
RCS

CHECKED BY
TRB

R&E Reichhardt & Ebe
ENGINEERING INC
P.O. Box 978 | 423 Front Street
Lynden, WA 98264 (360) 354-3687

| NO. | DATE | DESCRIPTION | BY |
|-----|------|-------------|----|
| | | | |




CITY OF FERDALE
2095 MAIN ST
FERDALE, WA 98248

MAIN STREET IMPROVEMENTS
BARRETT ROAD TO OLD SETTLERS DRIVE
ROADWAY AND STORM PLAN - STA 24+75 TO 29+75

| | | | |
|----------------|-----------------------------|-------------------|--|
| DWG 22015 PLOT | | DATE 3/29/24 | |
| JOB# 22015 | SCALE H: 1"=20' V: 1"=2' | SHEET 13 of 64 | |



P:\Projects\2015\03\20150315\0315_PLOT.dwg, 13 ROADWAY AND STORM PLAN - STA 24+75 TO 29+75, 3/29/2024 3:07:59 PM, AutoCAD PDF (General Documentation).pc3

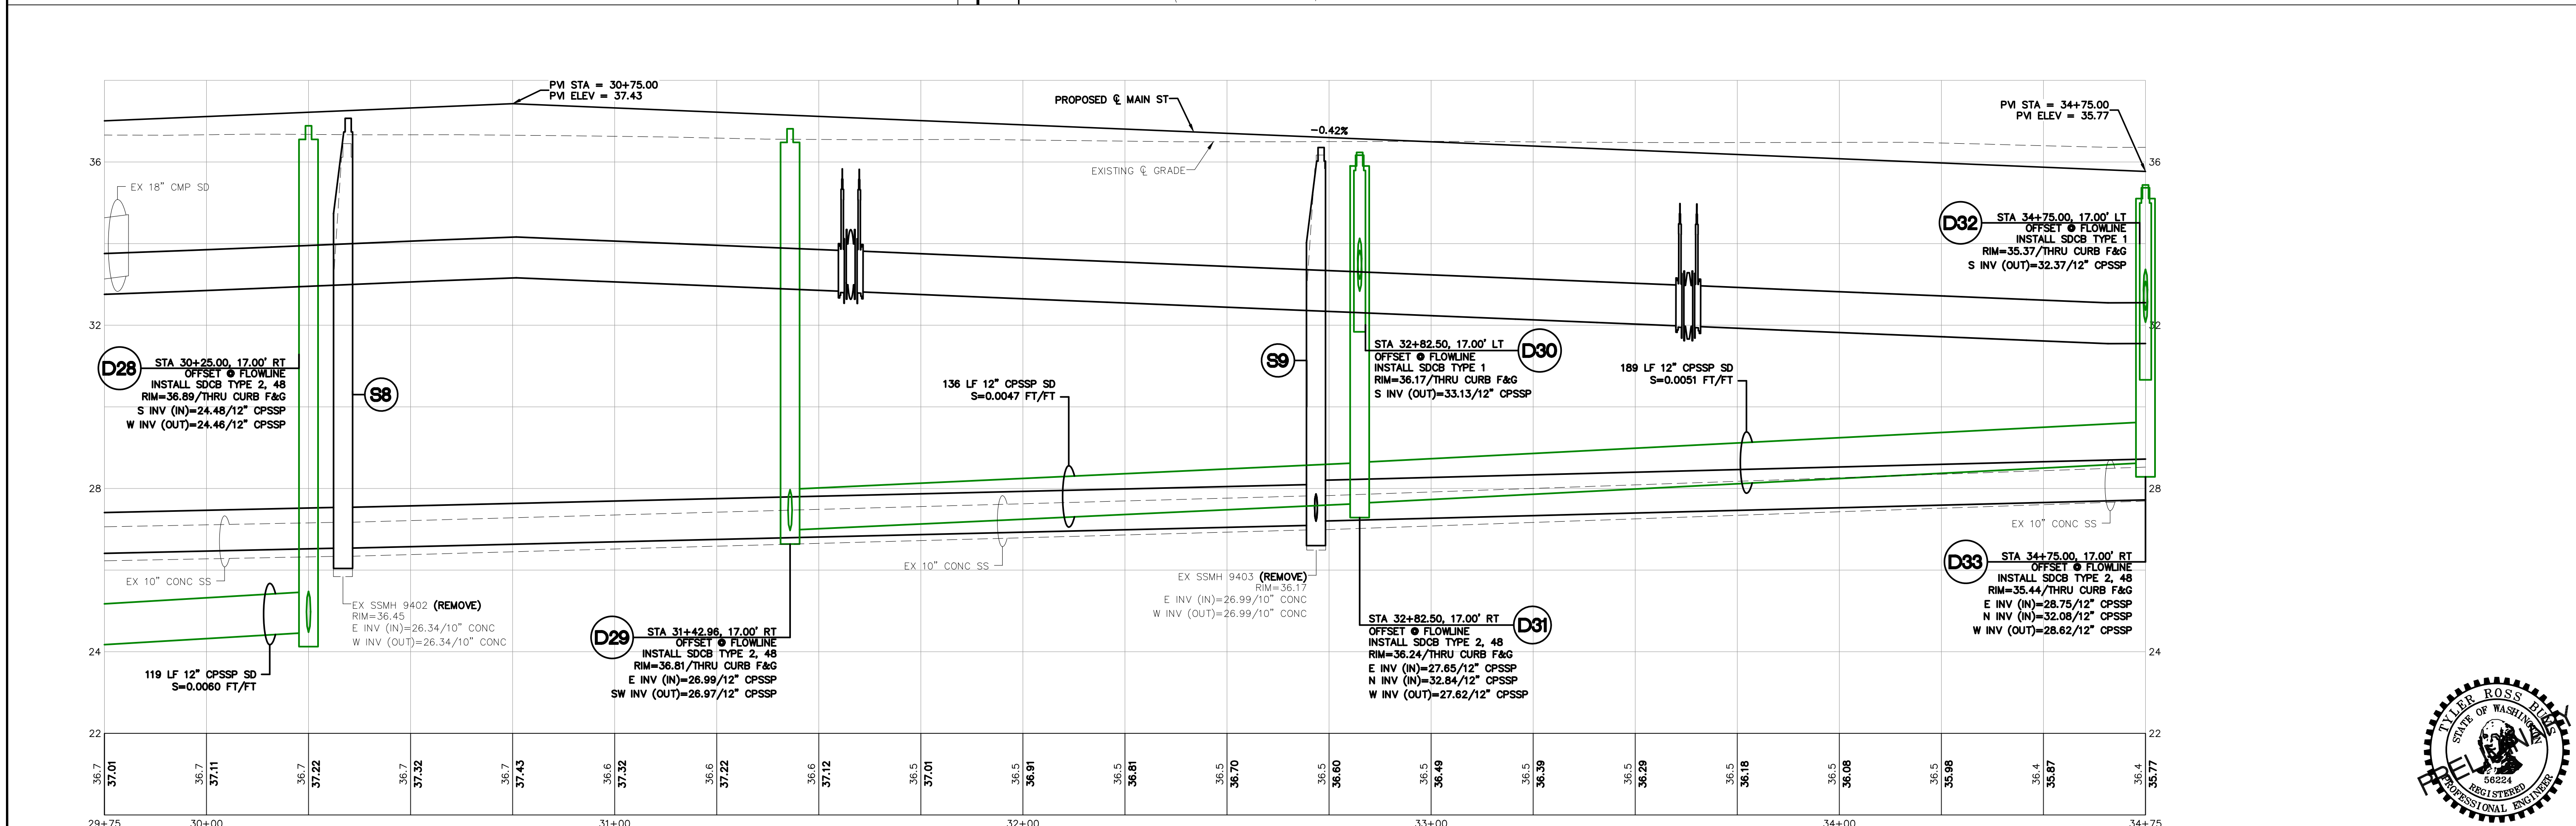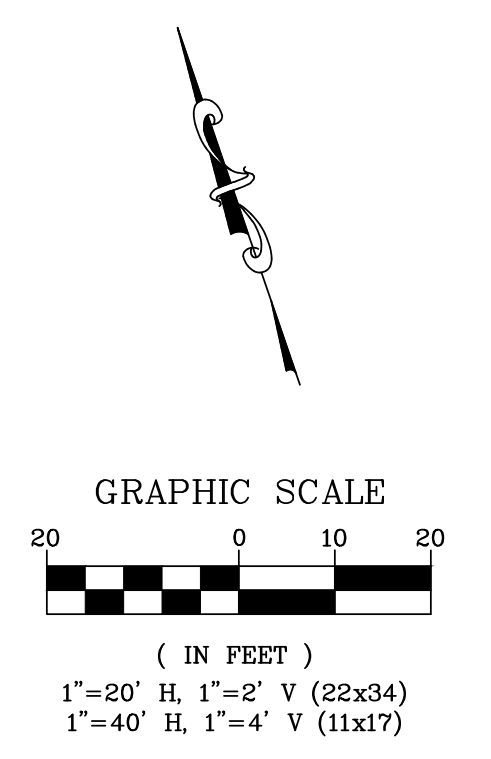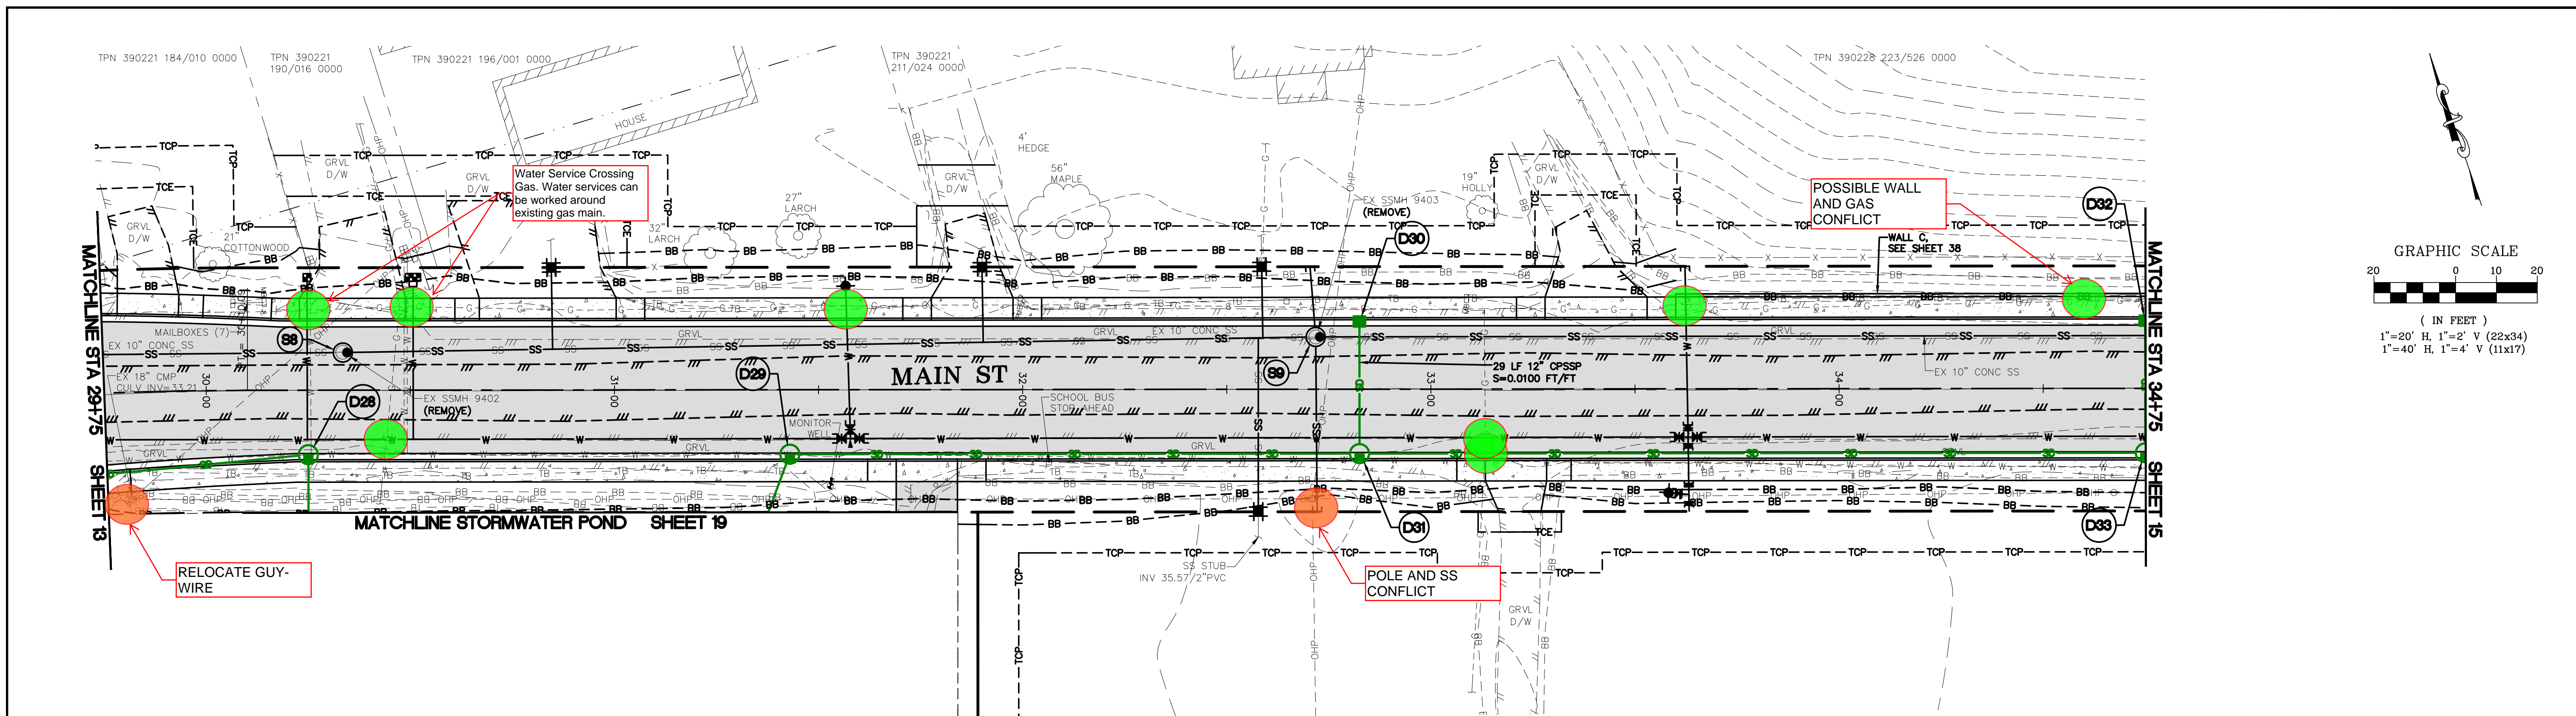

60% PLANS

DESIGNED BY
TRB
DRAWN BY
RCS
CHECKED BY
TRB

R&E Reichhardt & Ebe
ENGINEERING INC
P.O. Box 978 | 423 Front Street
Lynden, WA 98264 (360) 354-3687

| NO. | DATE | DESCRIPTION | BY |
|-----|------|-------------|----|
| | | | |




CITY OF FERDALE
2095 MAIN ST
FERDALE, WA 98248

MAIN STREET IMPROVEMENTS
BARRETT ROAD TO OLD SETTLERS DRIVE
ROADWAY AND STORM PLAN - STA 29+75 TO 34+75

| | | |
|----------------|-----------|----------|
| DWG 22015 PLOT | | DATE |
| JOB# 22015 | | 3/29/24 |
| SCALE | H: 1"=20' | V: 1"=2' |
| SHEET | | 14 |
| of 64 | | |



P:\Projects\2015\03\20150315_PLOT.dwg - H:ROADWAY AND STORM PLAN - STA 29+75 TO 34+75, 3/29/24 3:08:43 PM - AutoCAD PDF (General Documentation).pc3

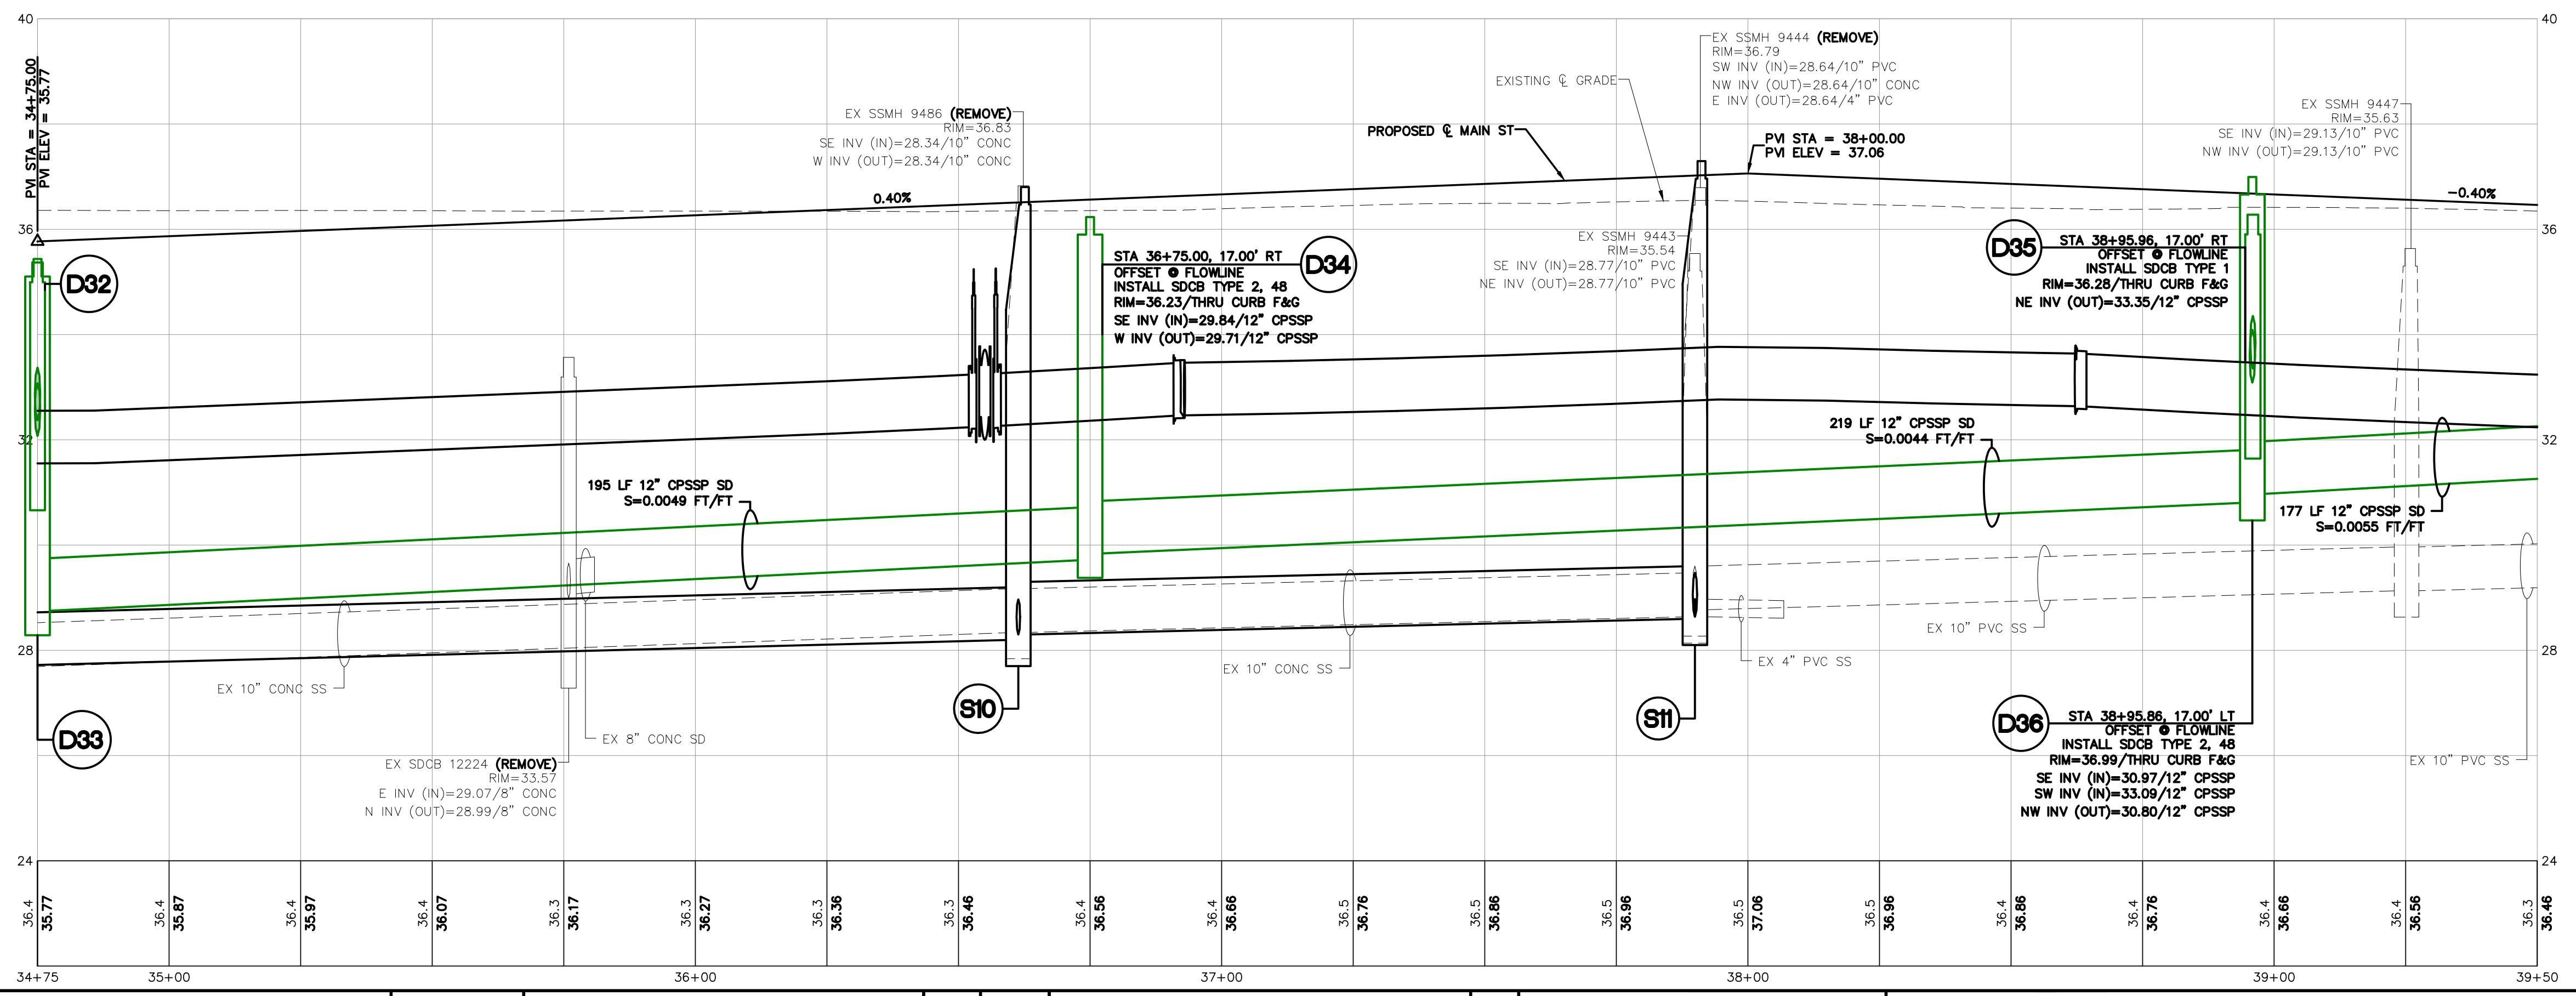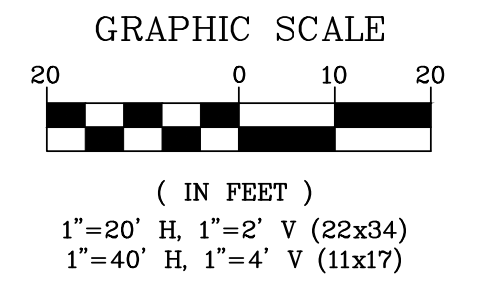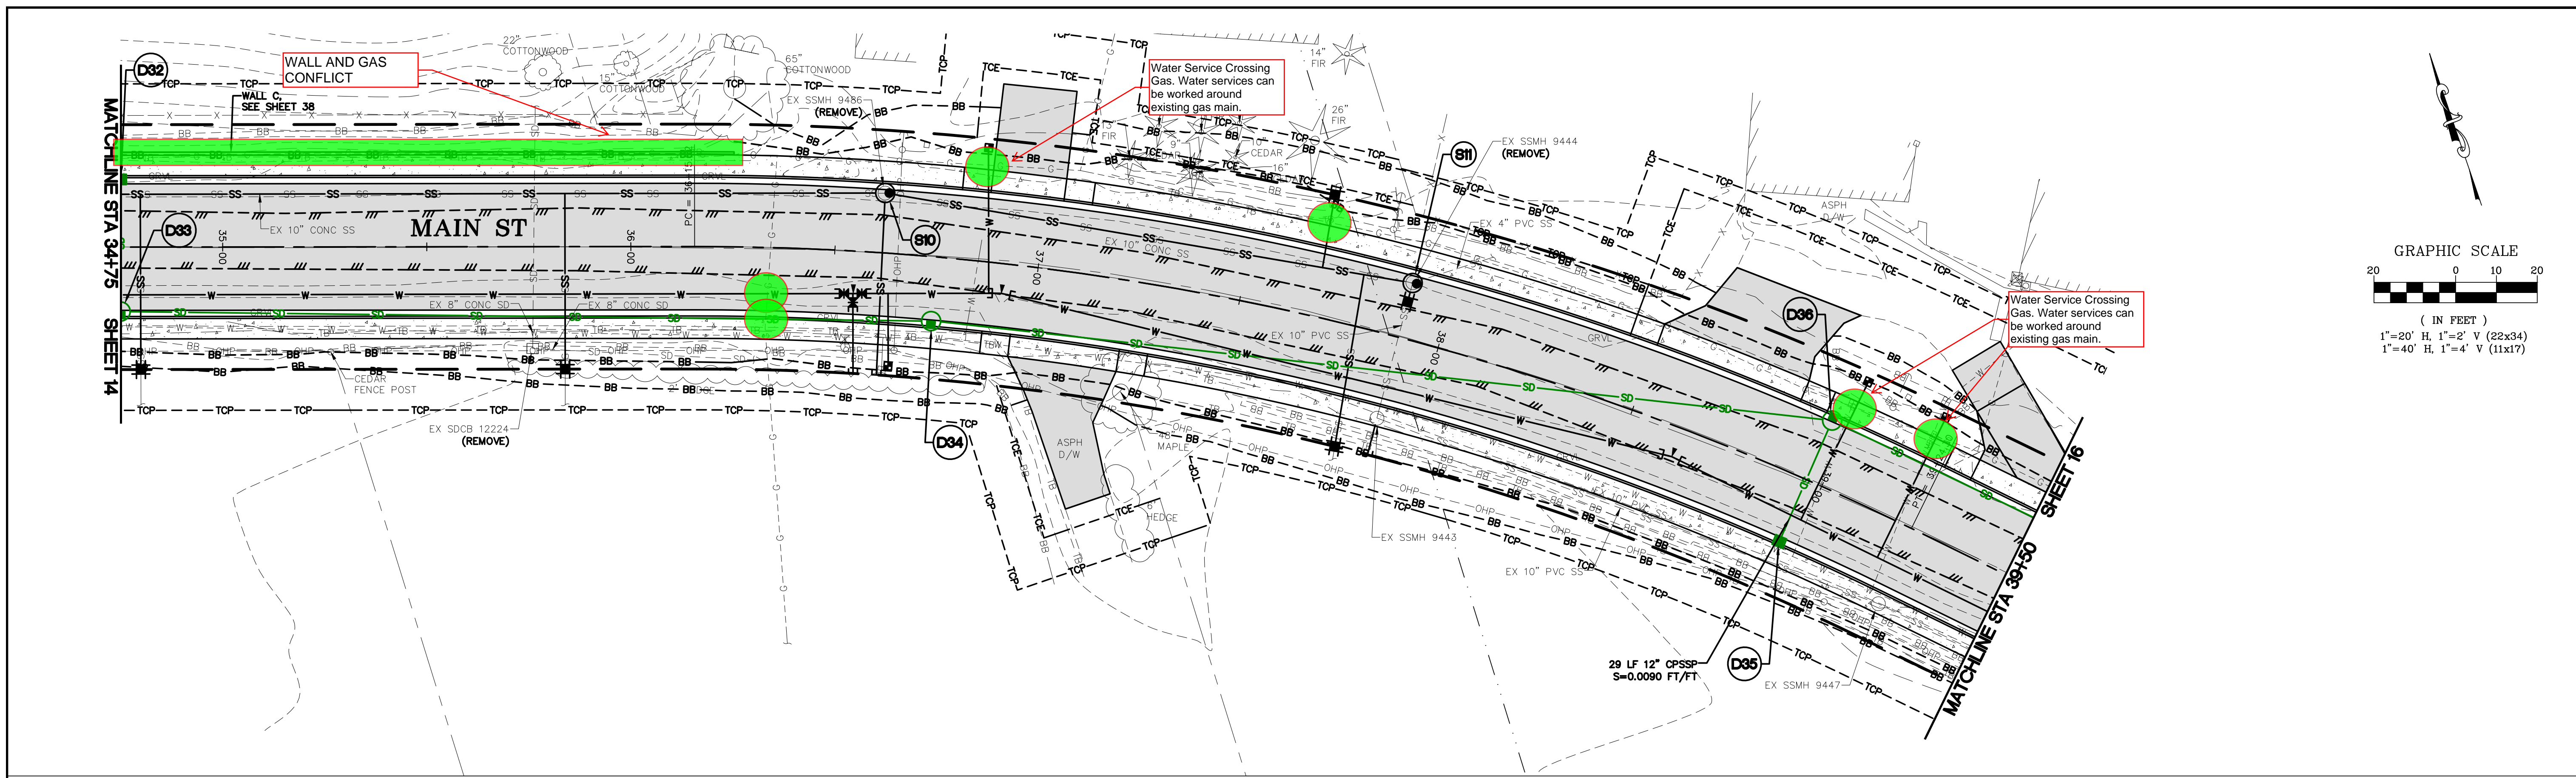

60% PLANS

DESIGNED BY
TRB

DRAWN BY
RCS

CHECKED BY
TRB

R&E Reichhardt & Ebe
ENGINEERING INC
P.O. Box 978 | 423 Front Street
Lynden, WA 98264 (360) 354-3687

| NO. | DATE | DESCRIPTION | BY |
|-----|------|-------------|----|
| | | | |

CITY OF FERDALE
2095 MAIN ST
FERDALE, WA 98248

MAIN STREET IMPROVEMENTS
BARRETT ROAD TO OLD SETTLERS DRIVE
ROADWAY AND STORM PLAN - STA 34+75 TO 39+50

DWG 22015 PLOT
JOB# 22015


SCALE
H: 1"=20' V: 1"=4'

DATE
3/29/24

SHEET
15
of 64





P:\Projects\2015\150315\150315_PLOT.dwg, 15 ROADWAY AND STORM PLAN - STA 34+75 TO 39+50, 3/29/24 3:09:24 PM, AutoCAD PDF (General Documentation) .pc3

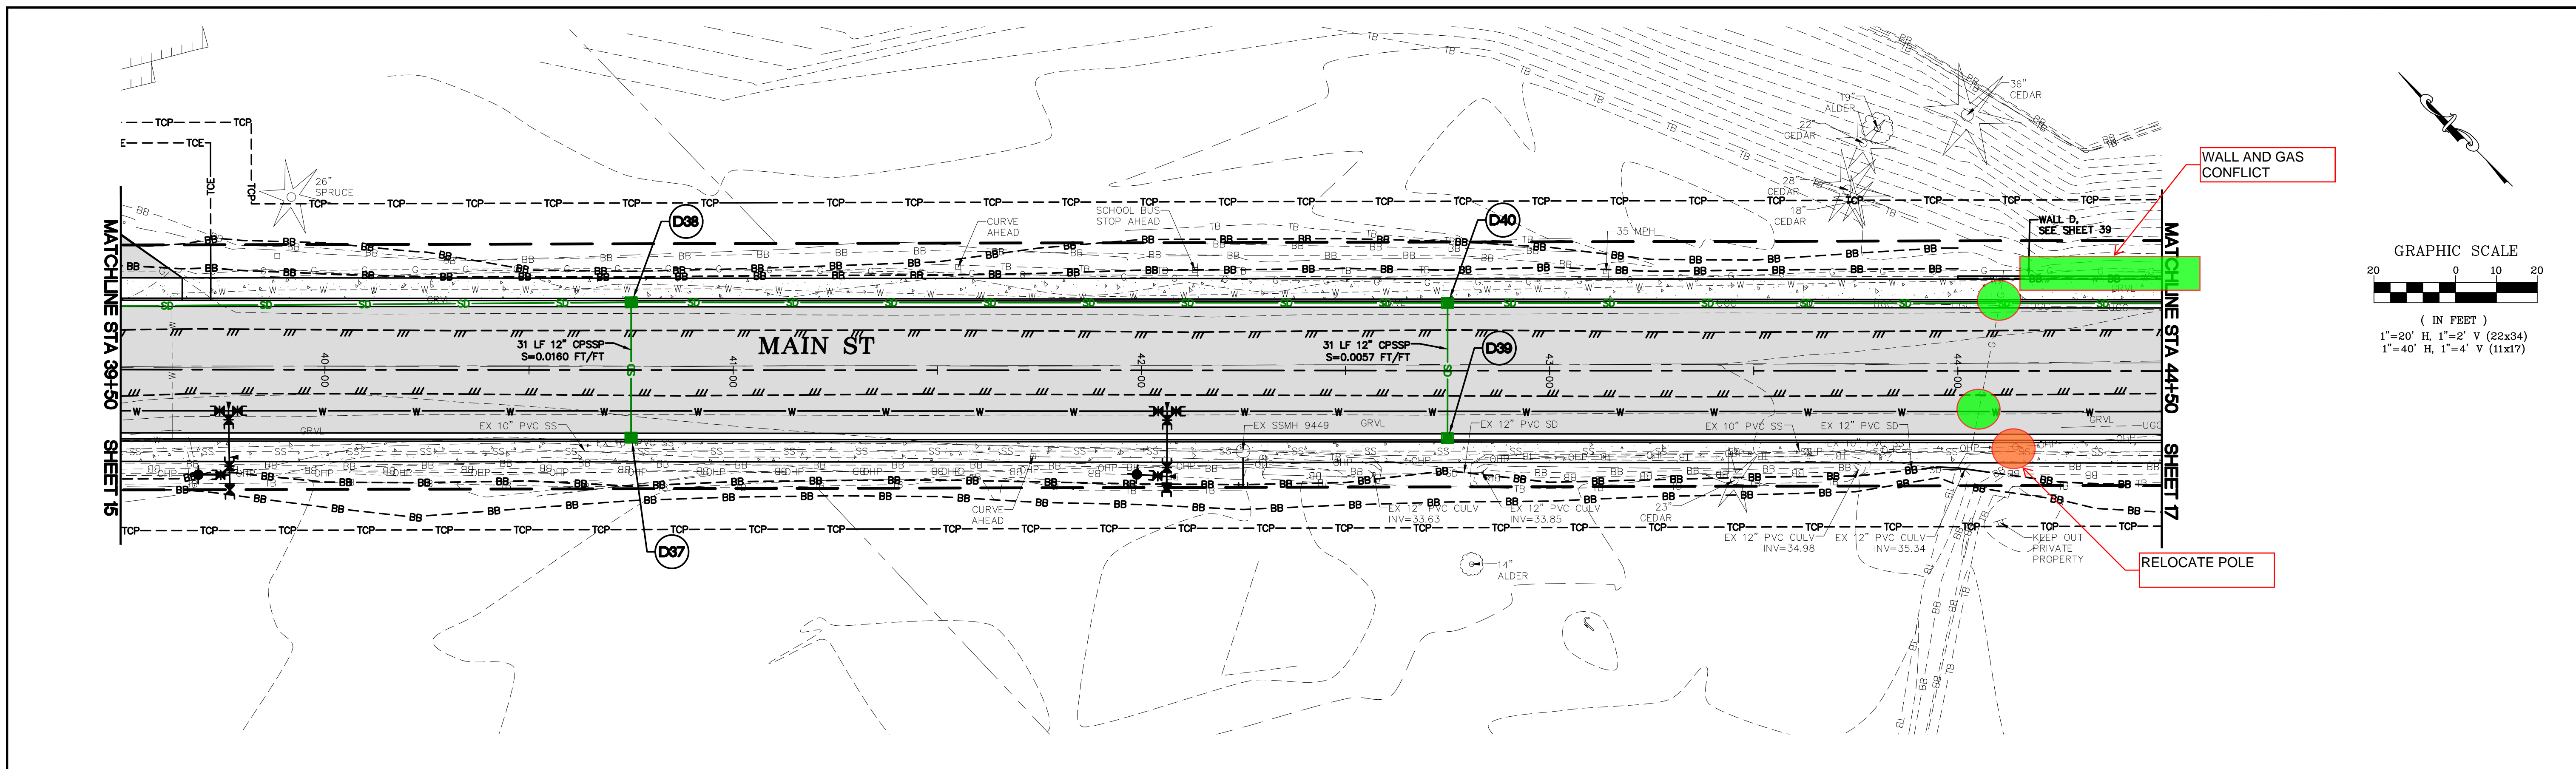

WALL AND GAS CONFLICT

RELOCATE POLE

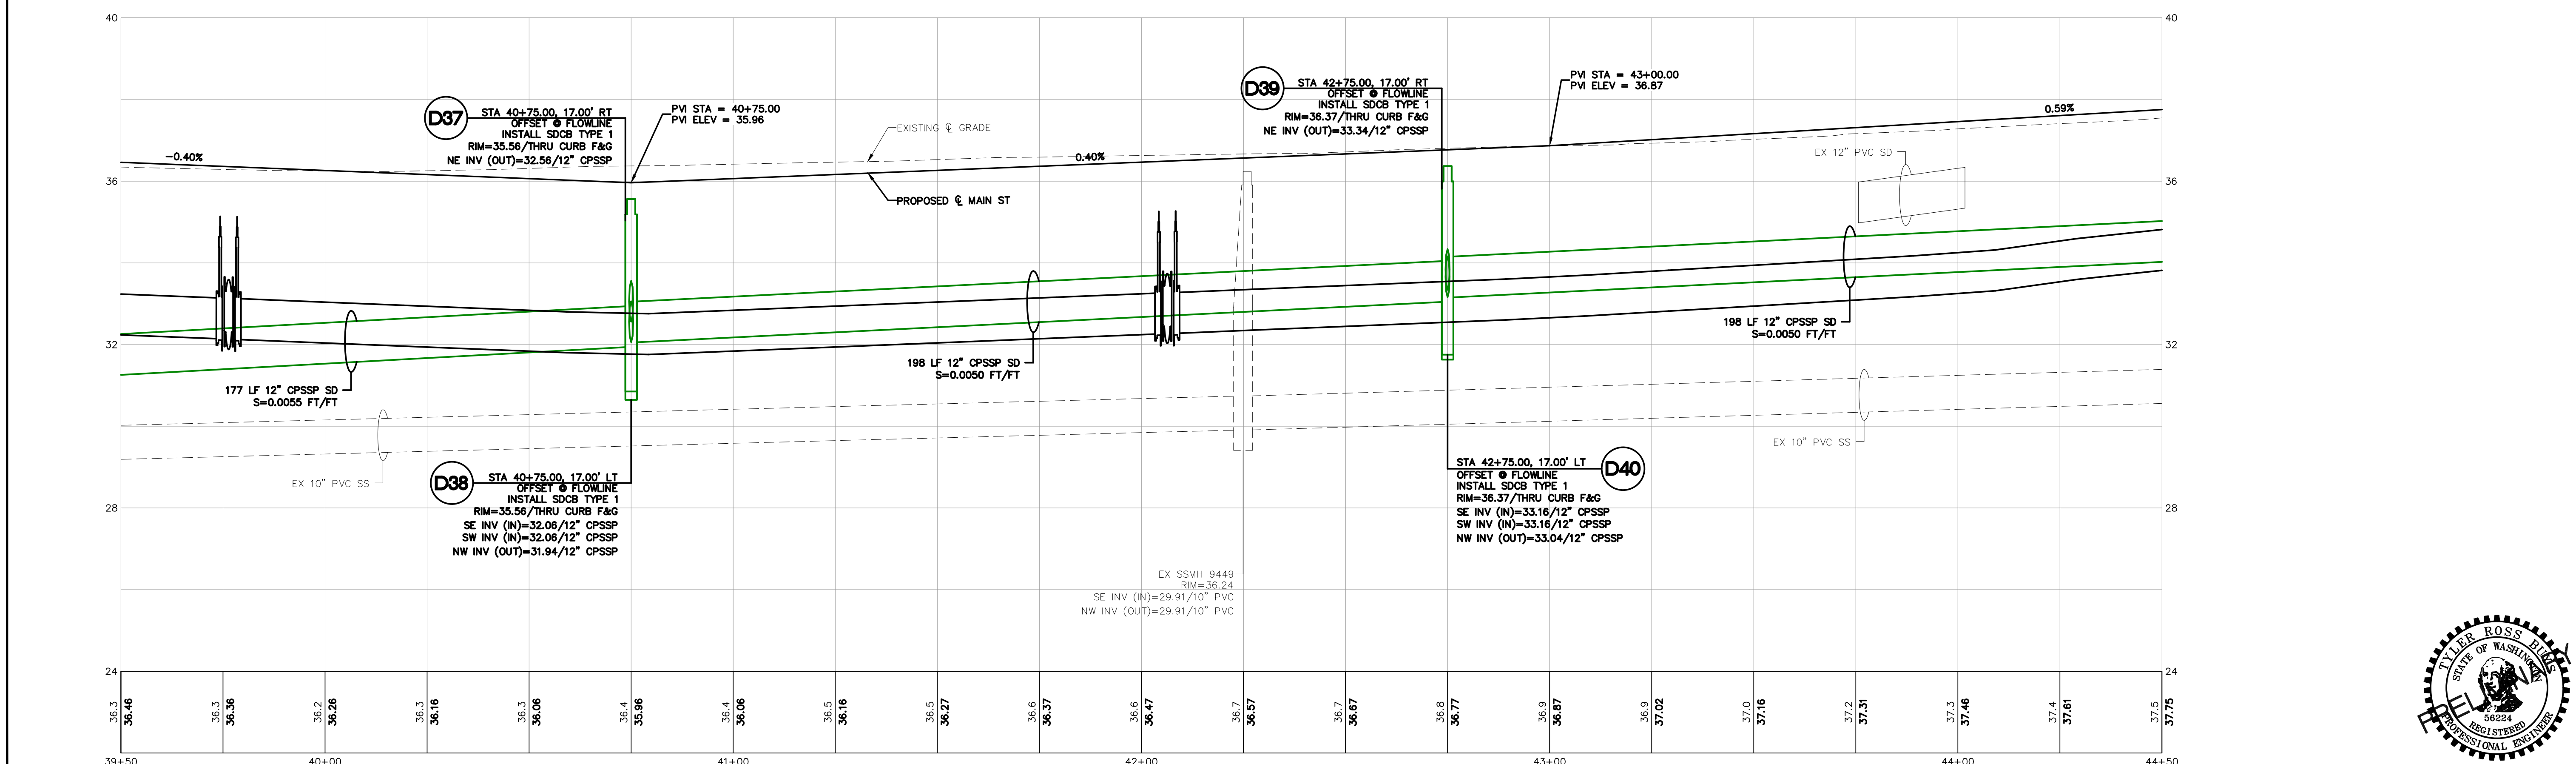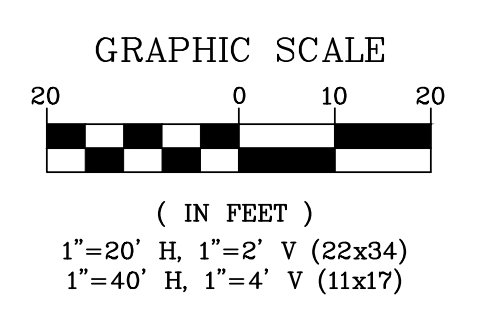

60% PLANS

DESIGNED BY
TRB

DRAWN BY
RCS

CHECKED BY
TRB

R&E Reichhardt & Ebe
ENGINEERING INC
P.O. Box 978 | 423 Front Street
Lynden, WA 98264 (360) 354-3687

| NO. | DATE | DESCRIPTION | BY |
|-----|------|-------------|----|
| | | | |

CITY OF FERDALE
2095 MAIN ST
FERDALE, WA 98248


MAIN STREET IMPROVEMENTS
BARRETT ROAD TO OLD SETTLERS DRIVE
ROADWAY AND STORM PLAN - STA 39+50 TO 44+50

| | | | |
|-------|------------|-------|--------------------|
| DWG# | 22015 PLOT | DATE | 3/29/24 |
| JOB# | 22015 | SCALE | H: 1"=20' V: 1"=2' |
| SHEET | 16 | | |
| | of 64 | | |



P:\Projects\2015\15015\15015_PLOT.dwg 15 ROADWAY AND STORM PLAN - STA 39+50 TO 44+50 3/29/2024 3:10:04 PM - AutoCAD PDF (General Documentation) .pc3



TPN 390228 346/526 0000

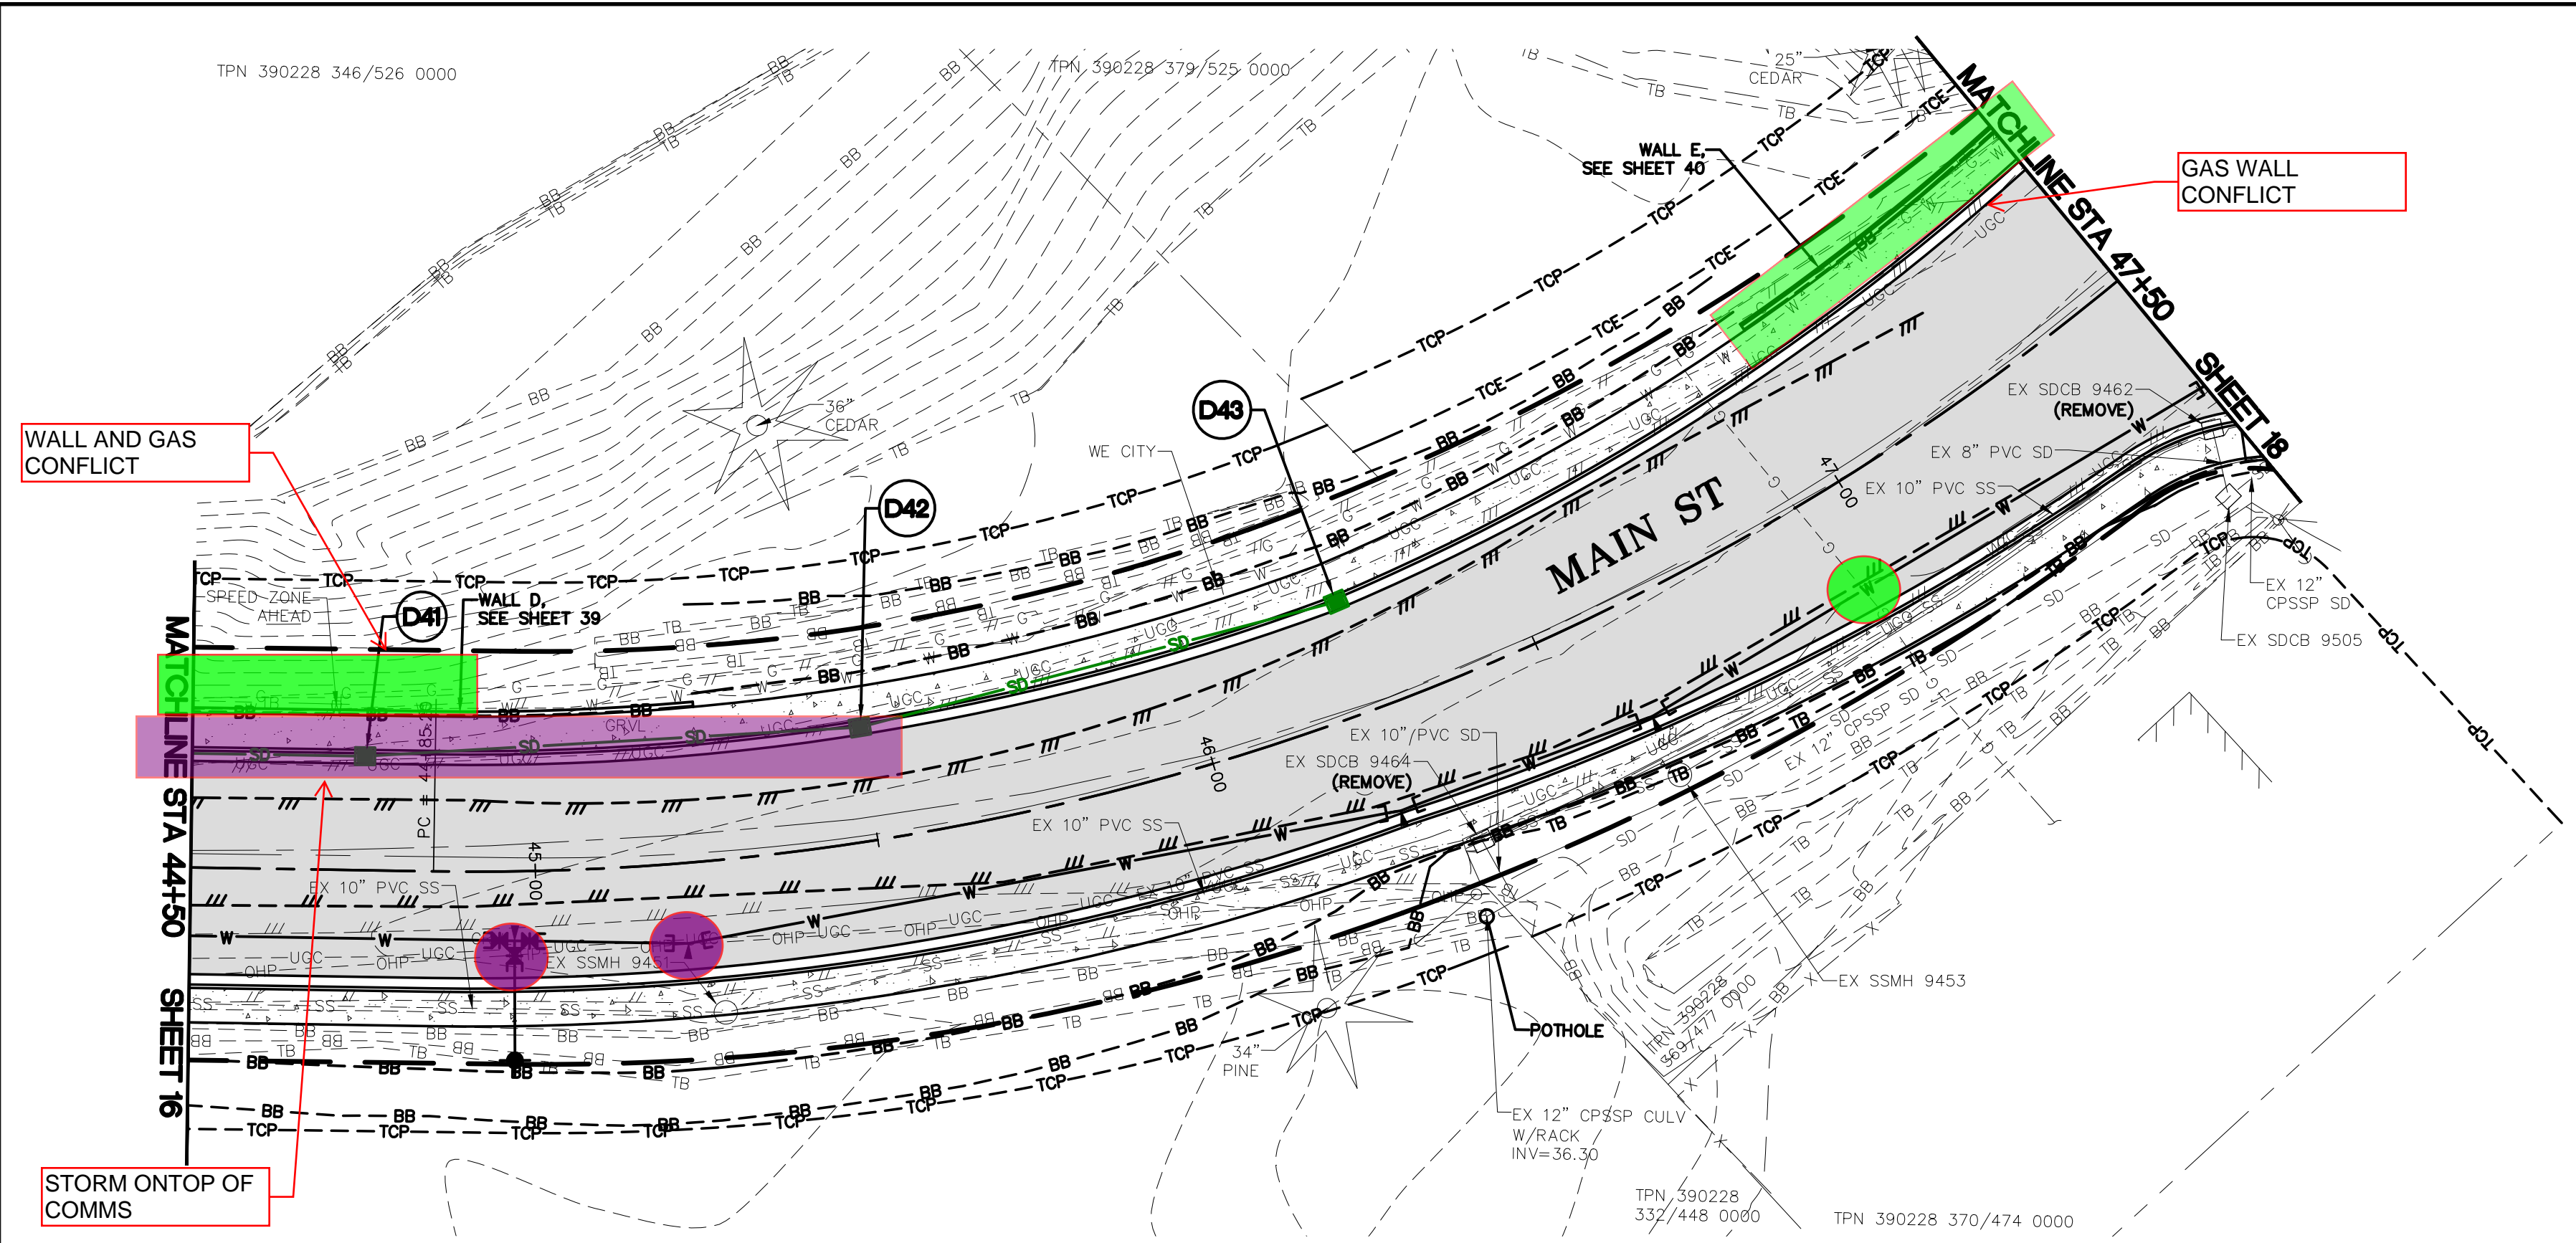


WALL AND GAS CONFLICT

GAS WALL CONFLICT

STORM ON TOP OF COMMS

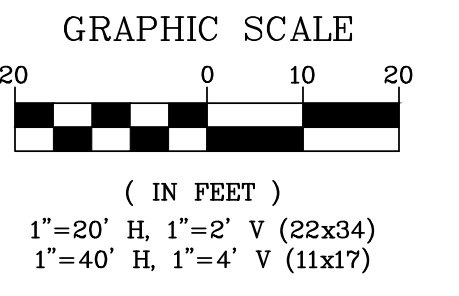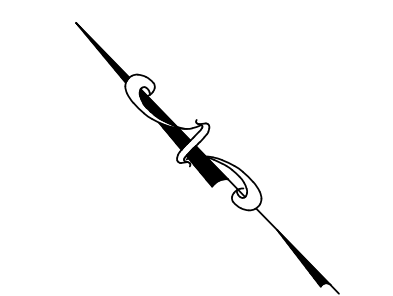

NOTE:
 1. CONTRACTOR TO POTHOLE AT EACH SPECIFIED LOCATION 5 DAYS PRIOR TO PLANNED INSTALLATION TO VERIFY FITTINGS.

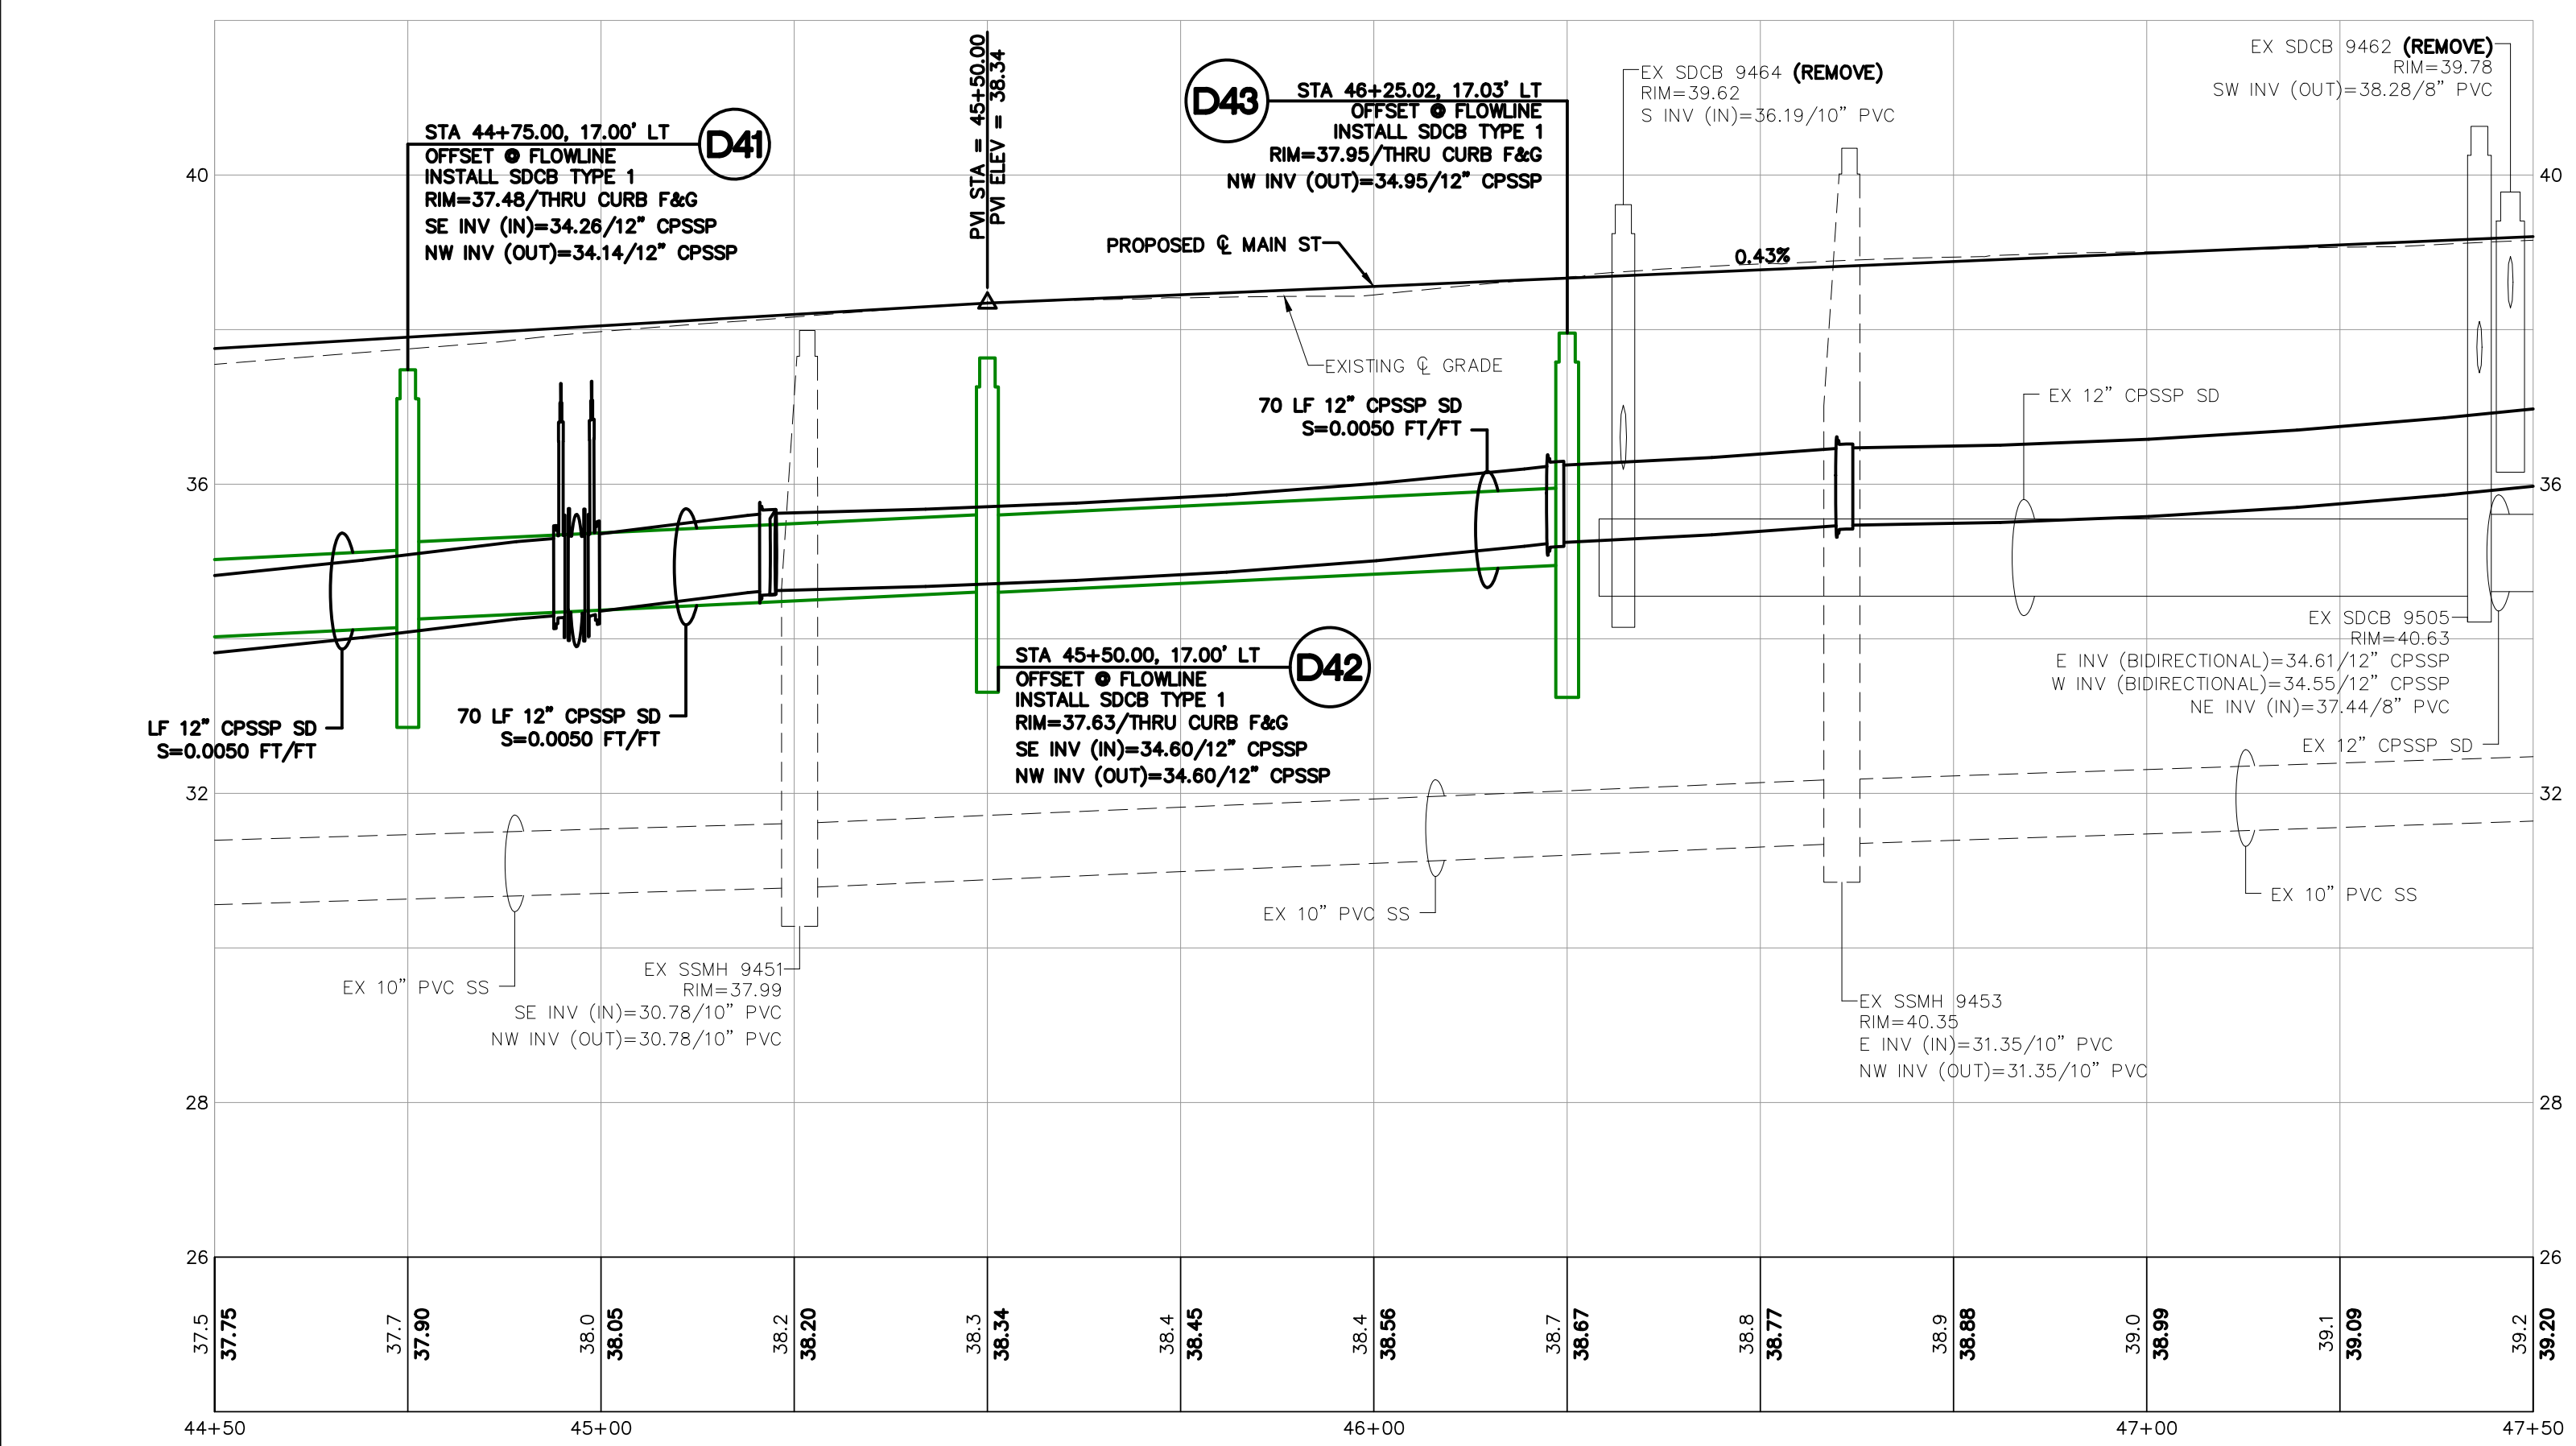

STA 44+75.00, 17.00' LT
 OFFSET @ FLOWLINE
 INSTALL SDCB TYPE 1
 RIM=37.48/THRU CURB F&G
 SE INV (IN)=34.26/12" CPSSP
 NW INV (OUT)=34.14/12" CPSSP

STA 45+25.02, 17.03' LT
 OFFSET @ FLOWLINE
 INSTALL SDCB TYPE 1
 RIM=37.95/THRU CURB F&G
 NW INV (OUT)=34.95/12" CPSSP

STA 45+50.00, 17.00' LT
 OFFSET @ FLOWLINE
 INSTALL SDCB TYPE 1
 RIM=37.63/THRU CURB F&G
 SE INV (IN)=34.60/12" CPSSP
 NW INV (OUT)=34.60/12" CPSSP



60% PLANS

DESIGNED BY
 TRB
 DRAWN BY
 RCS
 CHECKED BY
 TRB

R&E Reichhardt & Ebe
 ENGINEERING INC
 P.O. Box 978 | 423 Front Street
 Lynden, WA 98264 (360) 354-3687




| NO. | DATE | DESCRIPTION | BY |
|-----|------|-------------|----|
| | | | |

CITY OF FERDALE
 2095 MAIN ST
 FERDALE, WA 98248

MAIN STREET IMPROVEMENTS
 BARRETT ROAD TO OLD SETTLERS DRIVE
 ROADWAY AND STORM PLAN - STA 44+50 TO 47+50

| | | | |
|-------|------------|-------|--------------------|
| DWG | 22015 PLOT | DATE | 3/29/24 |
| JOB# | 22015 | SCALE | H: 1"=20' V: 1"=2' |
| SHEET | 17 | of 64 | |

P:\Projects\2015\1501\1501501501_PLOT.dwg, 17 ROADWAY AND STORM PLAN - STA 44+50 TO 47+50, 3/29/24 3:10:53 PM, AutoCAD PDF (General Documentation).pc3

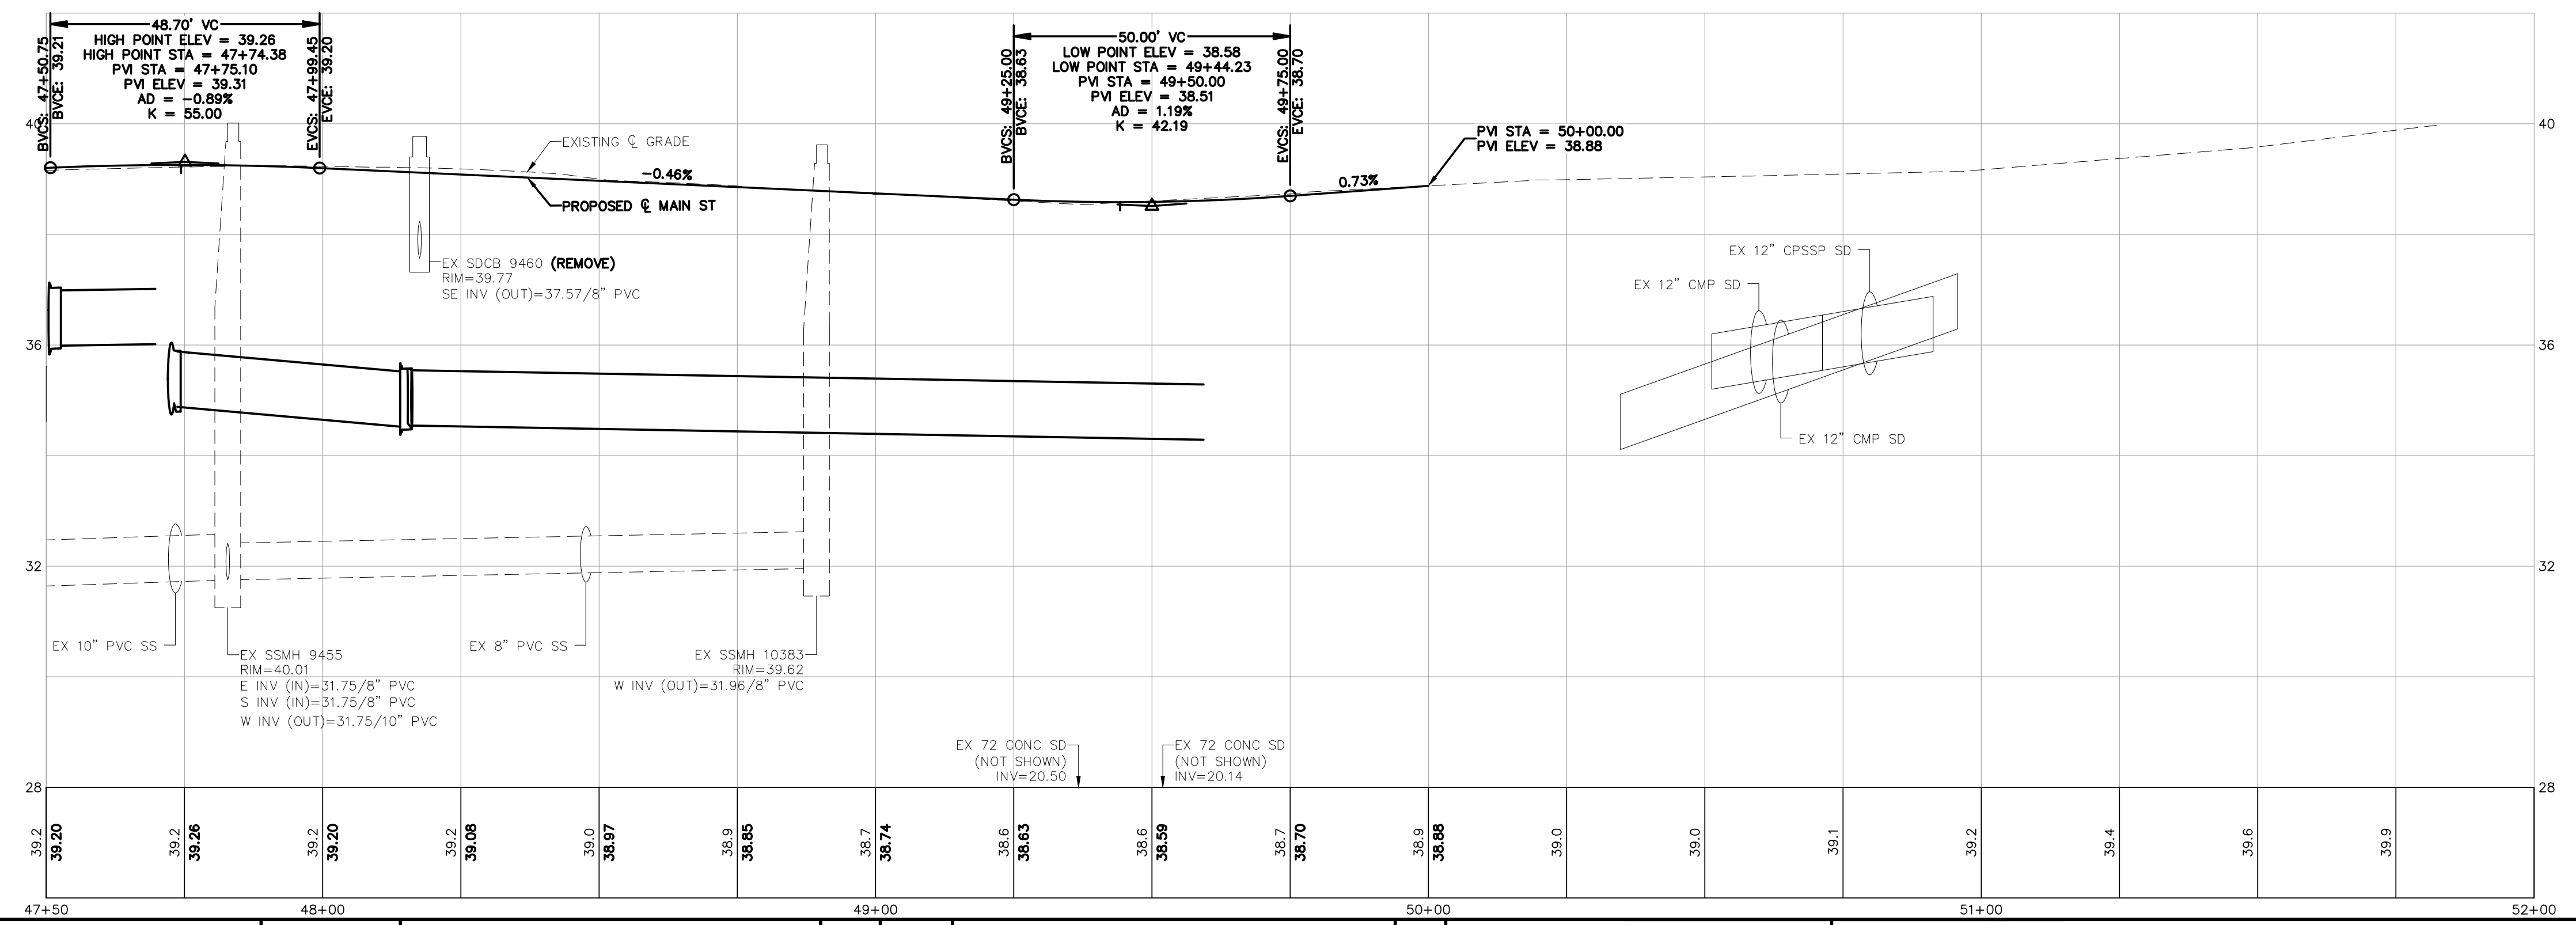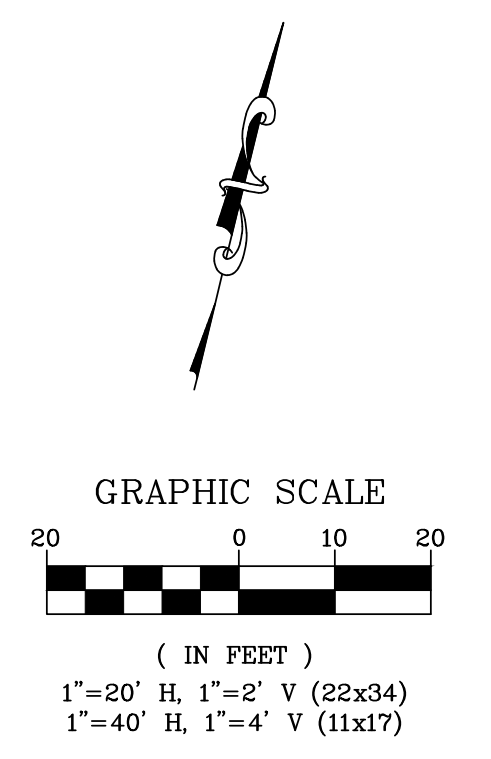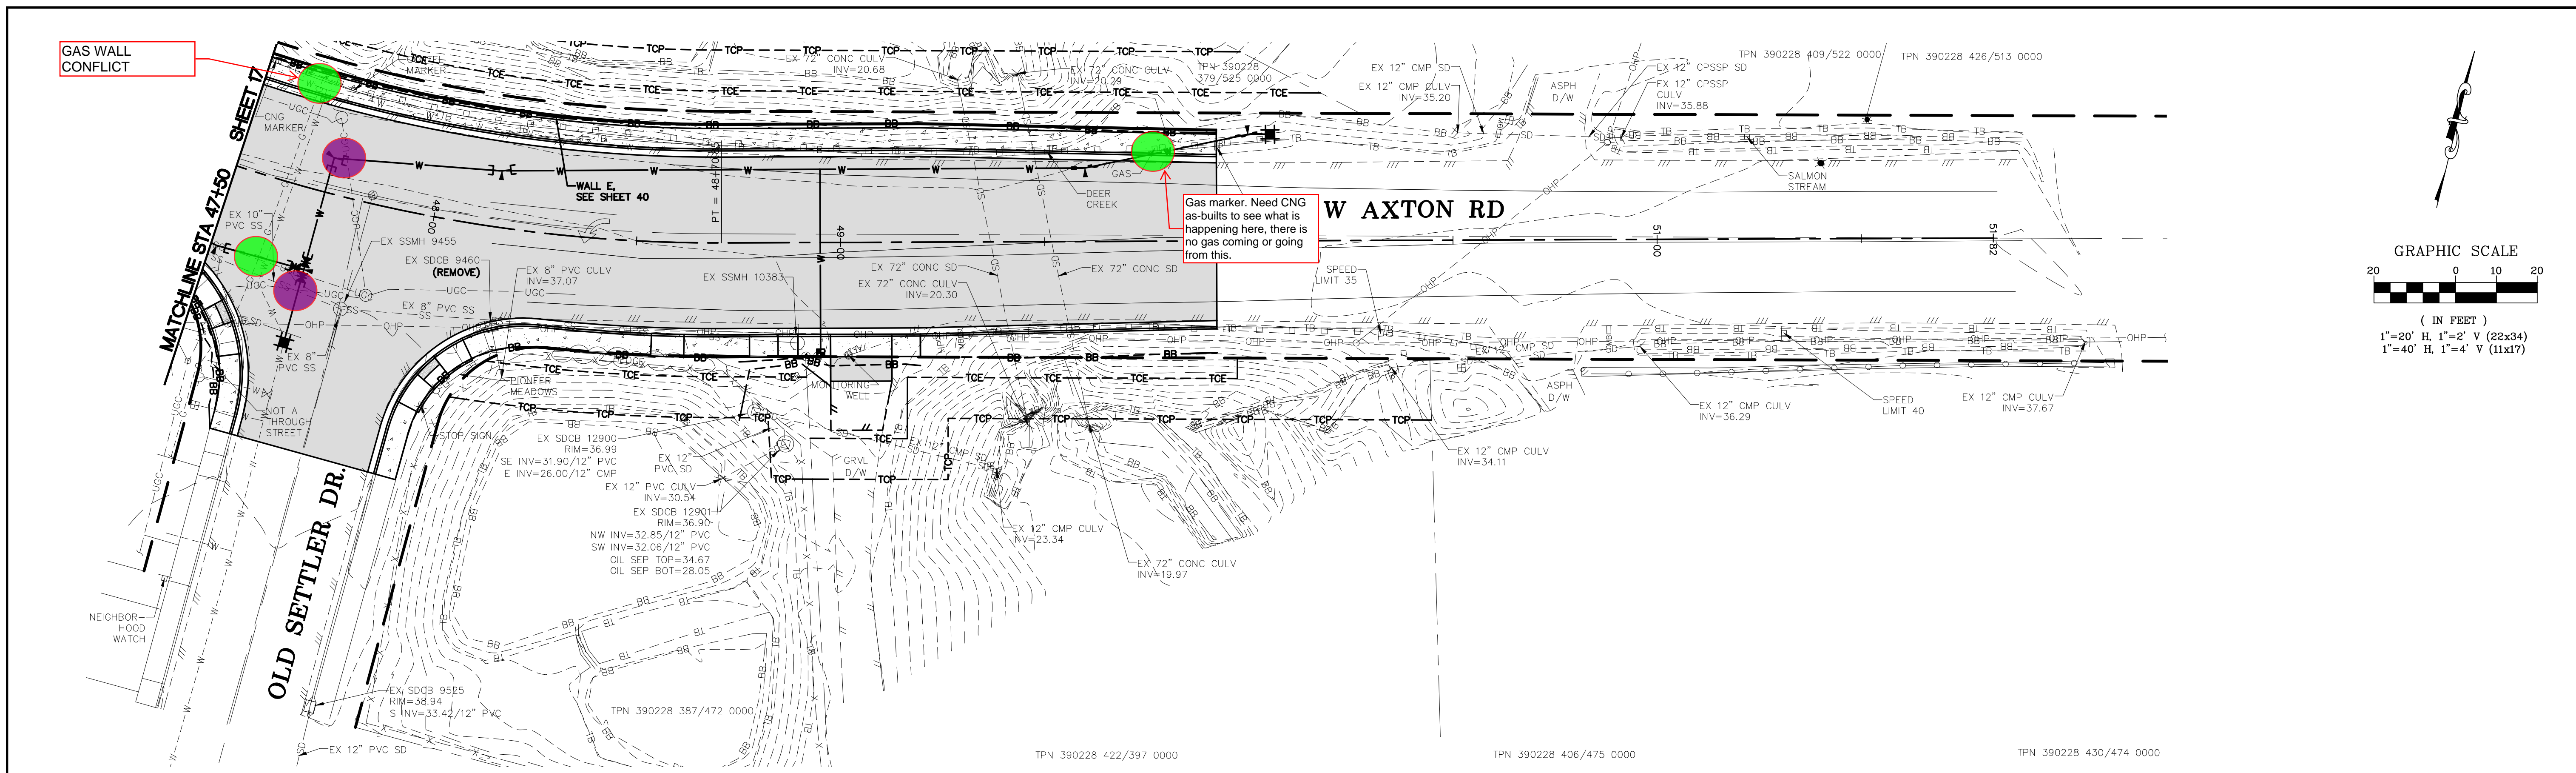

60% PLANS

DESIGNED BY
TRB
DRAWN BY
RCS
CHECKED BY
TRB

R&E Reichhardt & Ebe
ENGINEERING INC
P.O. Box 978 | 423 Front Street
Lynden, WA 98264 (360) 354-3687

| NO. | DATE | DESCRIPTION | BY |
|-----|------|-------------|----|
| | | | |

CITY OF FERDALE
2095 MAIN ST
FERDALE, WA 98248

MAIN STREET IMPROVEMENTS
BARRETT ROAD TO OLD SETTLERS DRIVE
ROADWAY AND STORM PLAN - STA 47+50 TO 52+00


DWG 22015 PLOT
JOB# 22015

SCALE
H: 1"=20' V: 1"=2'


DATE
3/29/24
SHEET
18
of 64




P:\Projects\2015\Civil\30 2015\2015 PLOT.dwg 18 ROADWAY AND STORM PLAN - STA 47+50 TO 52+00_302024_31144.PLT _AutoCAD PDF (General Documentation).pc3

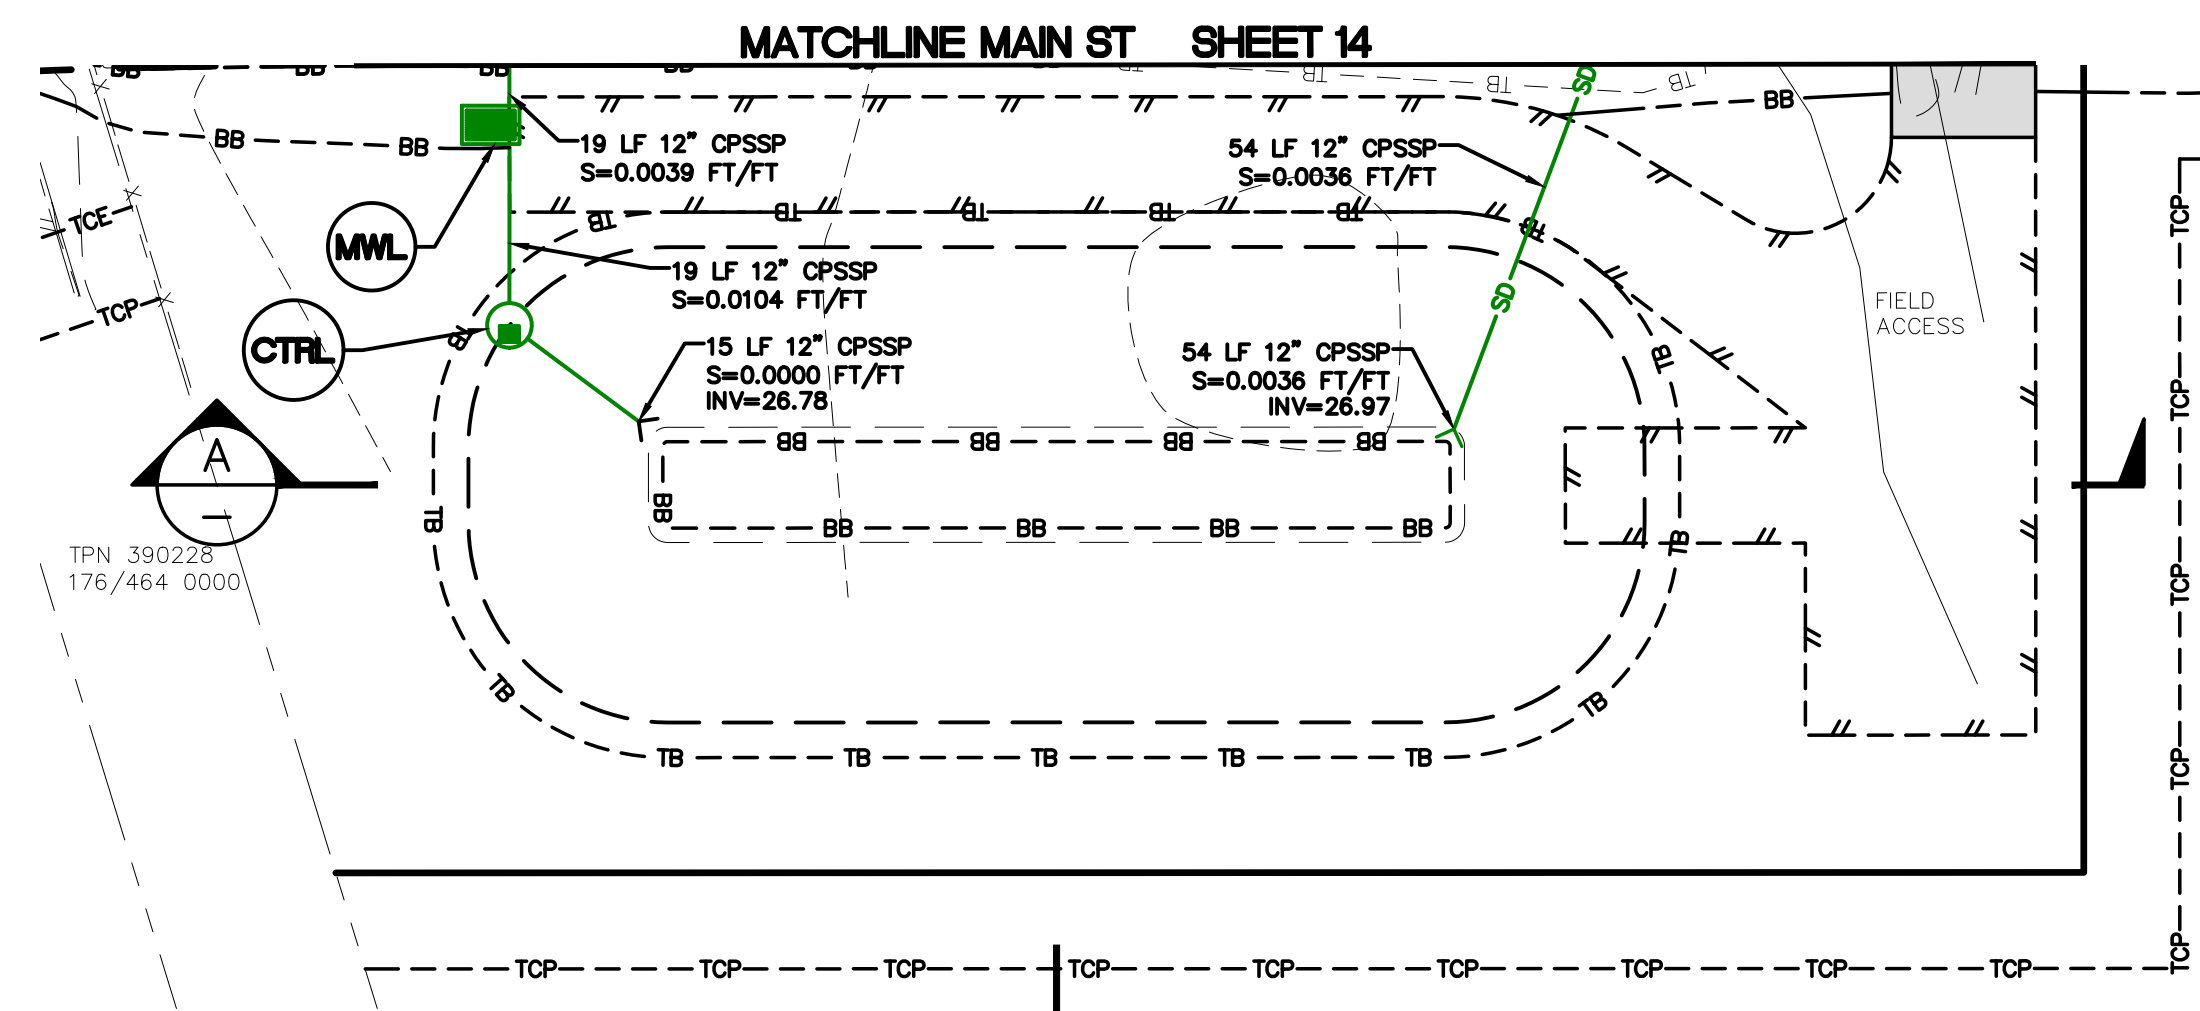


STA 30+25.03, 36.28'RT
 INSTALL: MODULAR WETLAND
 RIM=34.25/STANDARD
 S INV (IN)=26.58/12" CPSSP
 N INV (OUT)=24.55/12" CPSSP

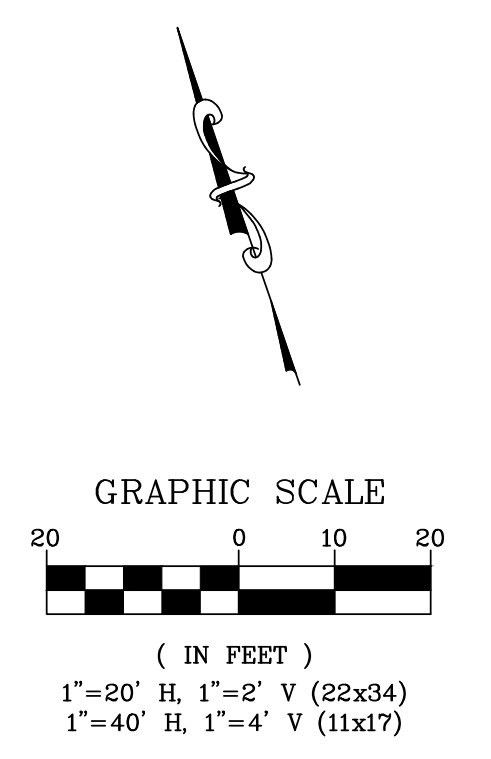

PLAN VIEW

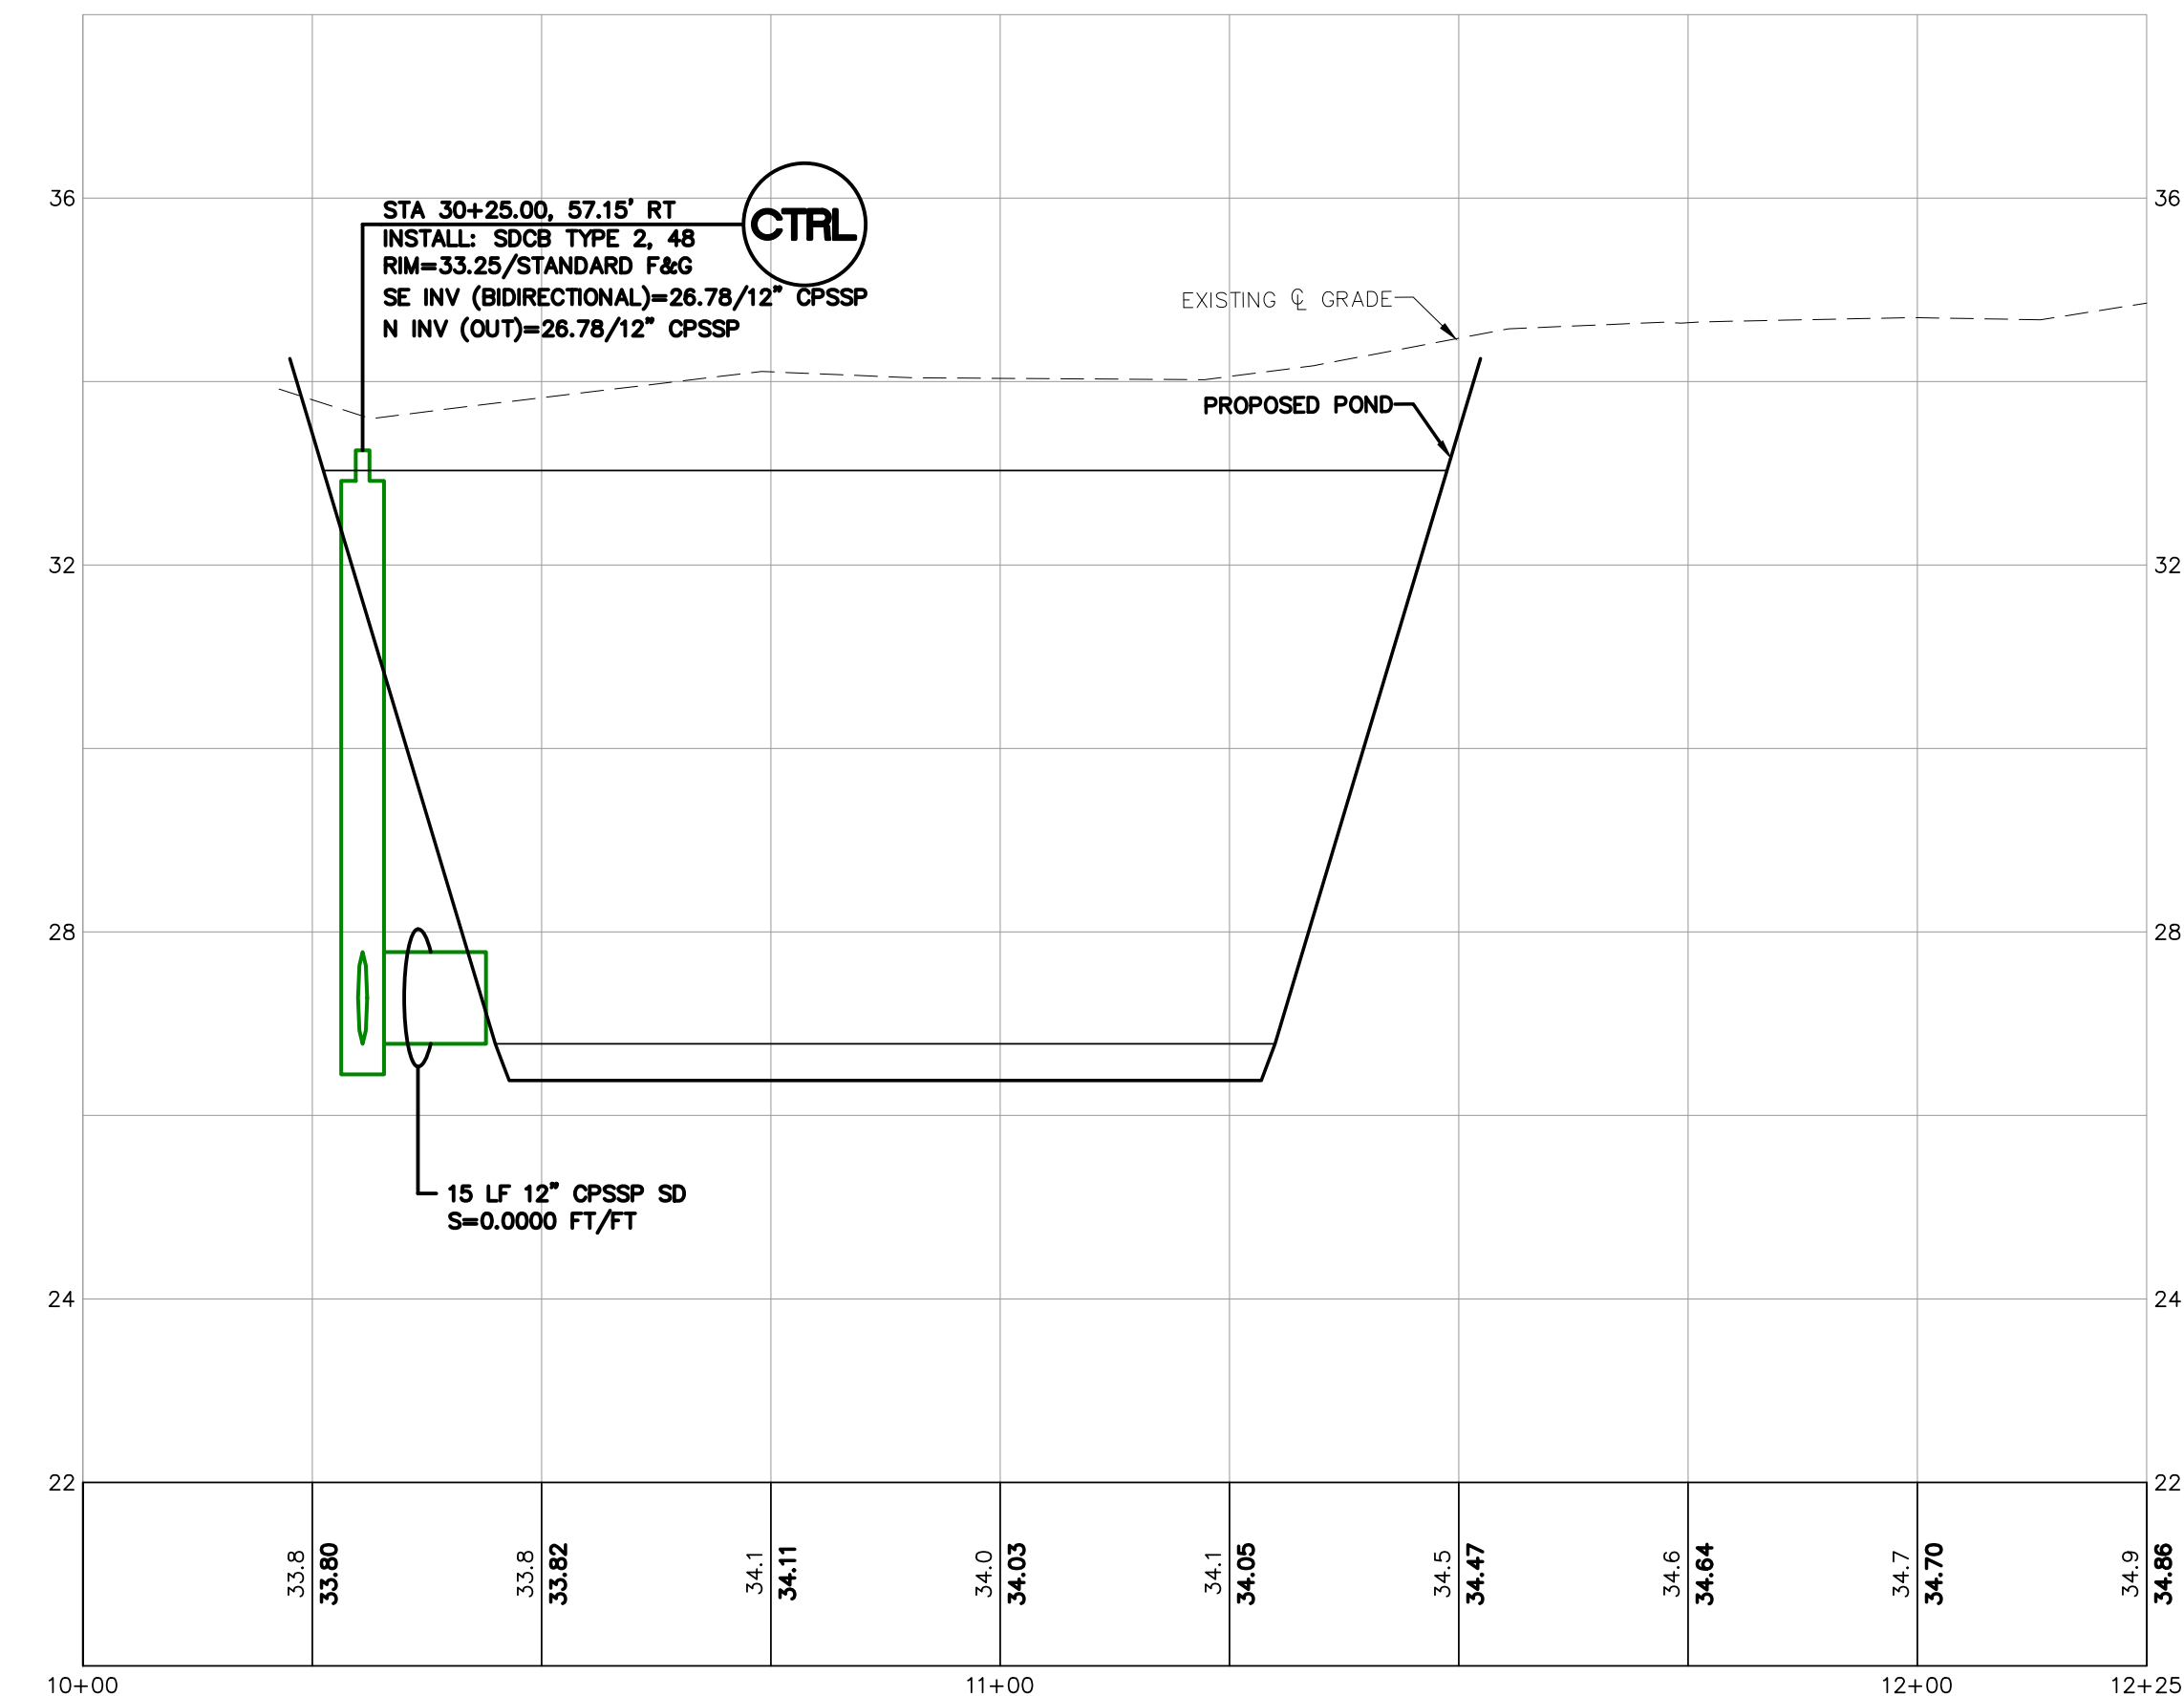

SECTION A

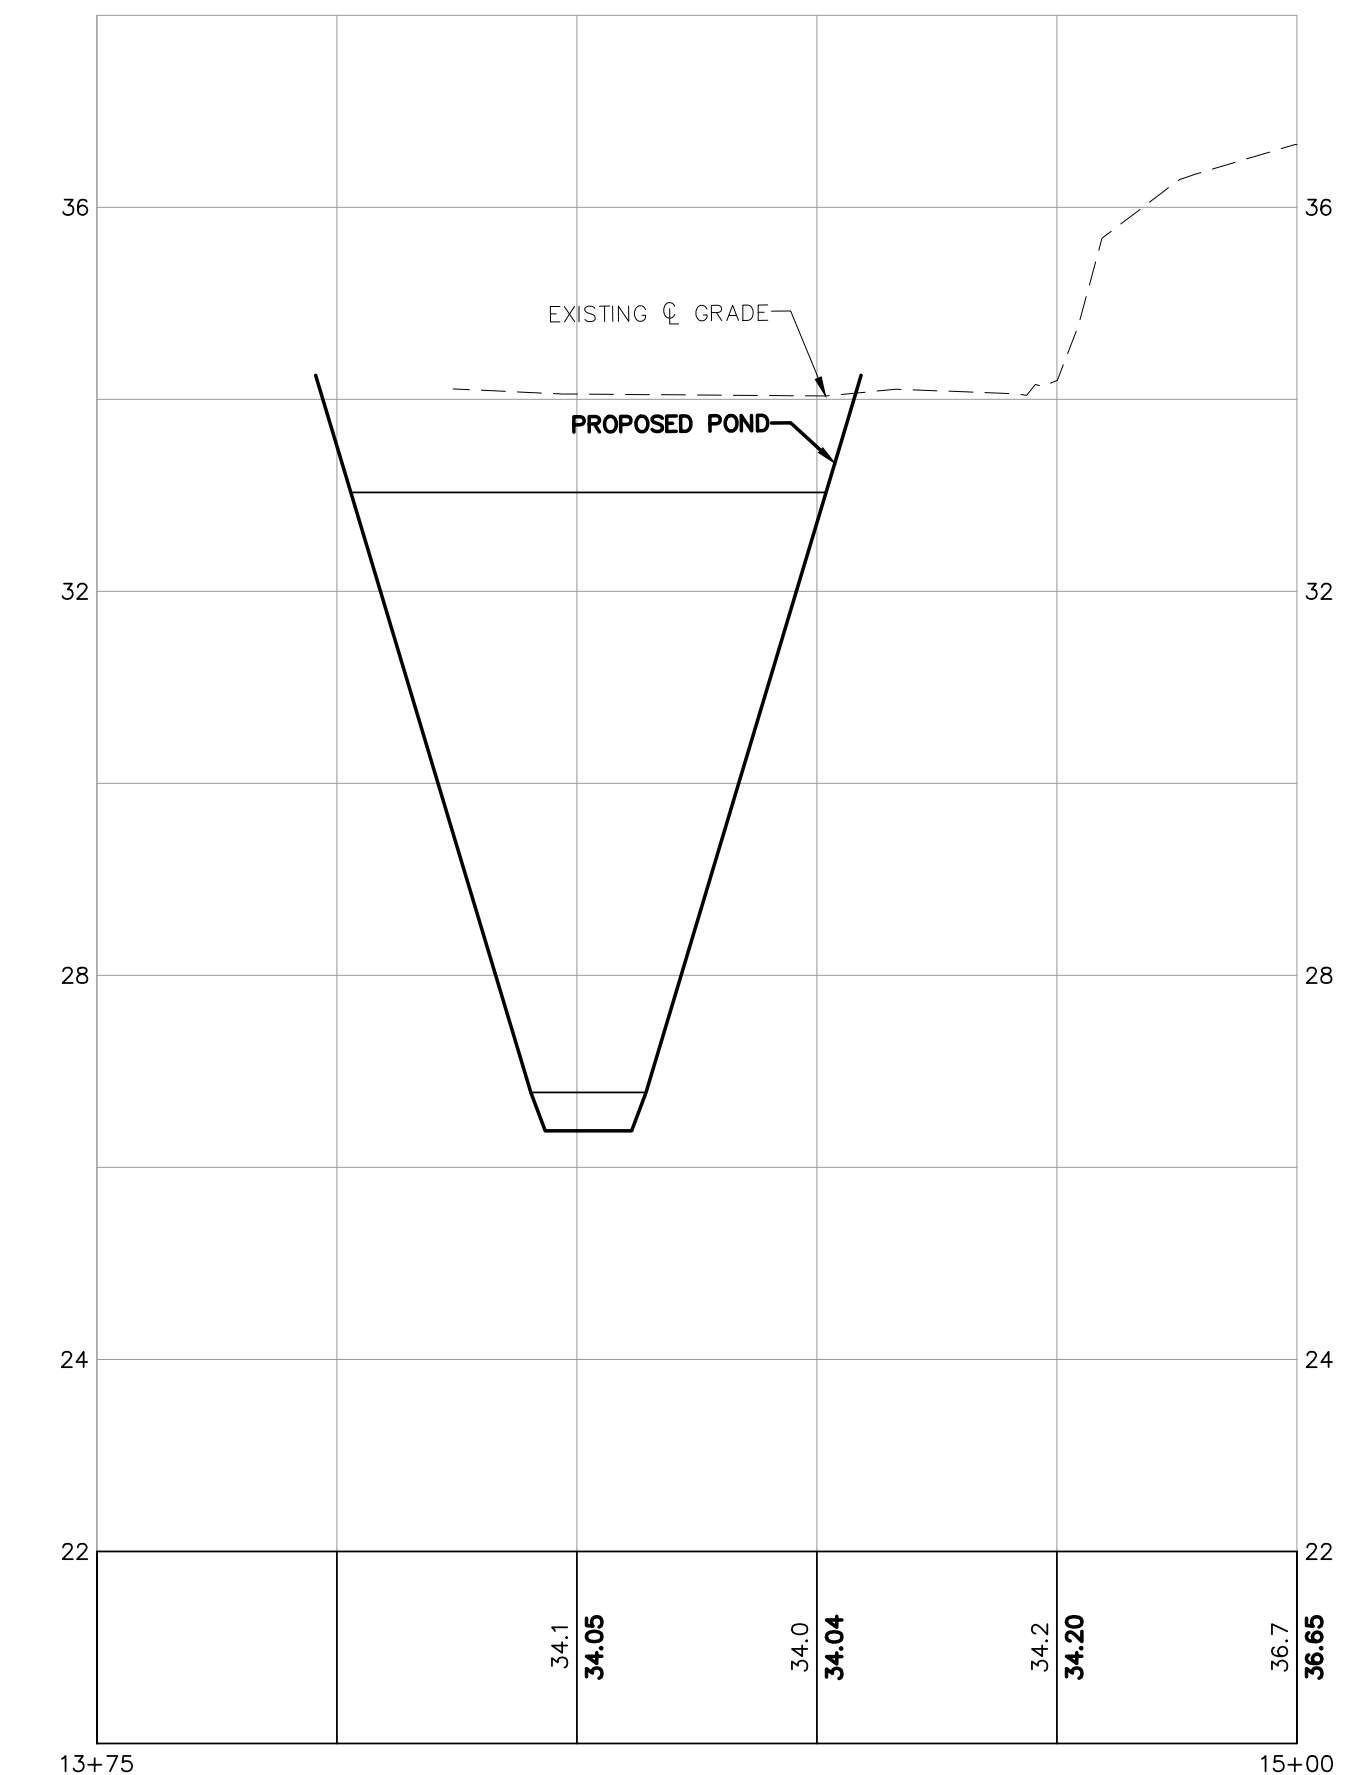

SECTION B



60% PLANS

DESIGNED BY
 TRB
 DRAWN BY
 RCS
 CHECKED BY
 TRB

R&E Reichhardt & Ebe
 ENGINEERING INC
 P.O. Box 978 | 423 Front Street
 Lynden, WA 98264 (360) 354-3687

| NO. | DATE | DESCRIPTION | BY |
|-----|------|-------------|----|
| | | | |
| | | | |
| | | | |

CITY OF FERDALE
 2095 MAIN ST
 FERDALE, WA 98248

MAIN STREET IMPROVEMENTS
 BARRETT ROAD TO OLD SETTLERS DRIVE
 STORMWATER POND

DWG 22015 PLOT
 JOB# 22015

SCALE
 H: 1"=20' V: 1"=2'

DATE 3/29/24
 SHEET 19 of 64

P:\Projects\2015\03\30 2015\2015 PLOT.dwg 10 STORMWATER POND 3/29/24 3:12:28 PM AutoCAD PDF (General Documentation) .pc3